FARRIS, HANSEN & ASSOC. INC.

7 RIDGWAY COURT- P.O. BOX 437 ELKHORN, WISCONSIN 53121 PHONE (262) 723-2098 FAX (262) 723-5886 PLAT OF SURVEY

LOTS 1, 2, & 3, BLOCK 7 EAST SIDE 2ND ADD.


LOCATED IN THE NE 1/4 OF THE SW 1/4 SEC. 22

TOWN 1 NORTH, RANGE 16 EAST, VILLAGE OF WALWORTH

WALWORTH COUNTY, WISCONSIN

TAX KEY NO. VES2 00011

ORDERED BY: DEREK & SANDY HOHISEL C/O THE RAULAND AGENCY WALWORTH, W.

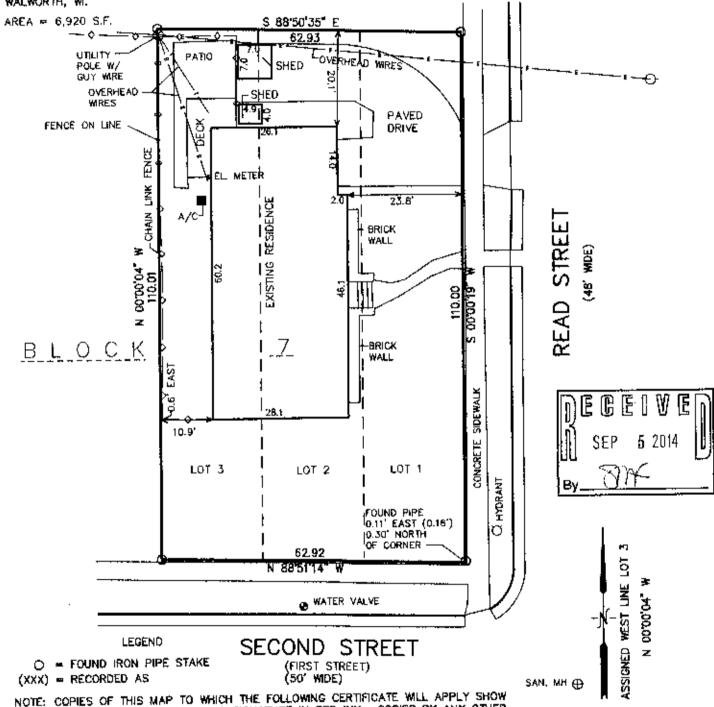

NOTE: COPIES OF THIS MAP TO WHICH THE FOLLOWING CERTIFICATE WILL APPLY SHOW THE SURVEYOR'S ORIGINAL SEAL AND SIGNATURE IN RED INK. COPIES BY ANY OTHER MEANS MAY HAVE ALTERATIONS WHICH DO NOT REPRESENT THE SURVEYOR'S WORK PRODUCT.

I HEREBY CERTIFY THAT THE ABOVE DESCRIBED PROPERTY HAS BEEN SURVEYED UNDER MY DIRECTION AND THAT THE ABOVE MAP IS A TRUE REPRESENTATION THEREOF AND SHOWS THE SIZE AND LOCATION OF THE PROPERTY, ITS EXTERIOR BOUNDARIES, THE LOCATION OF ALL VISIBLE STRUCTURES, AND DIMENSIONS OF ALL PRINCIPLE BUILDINGS THEREON, BOUNDARY FENCES, APPARENT EASEMENTS, ROADWAYS, AND VISIBLE ENCROACHMENTS, IF ANY. THIS SURVEY IS MADE FOR THE USE OF THE PROPERTY, AND ALSO THOSE WHO PURCHASE, MORTGAGE, OR GUARANTEE THE TITLE THERETO WITHIN ONE YEAR FROM THE DATE HEREOF.

PETER S.
GONCON
S-CIKIT
ELKHORN,
WI

SUP

DATED: JUNE 27, 2014

PROJECT NO. 9076

DATED: 06-27-2014 SHEET 1 OF 1 SHEETS 10 5 0 10 20 30 40 50 60 70 80 90 100 MAP SCALE IN FEET ORIGINAL 1" = 20'