

FARRIS, HANSEN & ASSOCIATES, INC.  
ENGINEERING — ARCHITECTURE — SURVEYING  
7 RIDGWAY COURT — P.O. BOX 437 — ELKHORN, WISCONSIN 53121  
PHONE: (262) 723-2098 FAX: (262) 723-5886




**PLAT OF SURVEY**  
**LOT 2 OF INDIAN PRAIRIE SUBDIVISION**  
A SUBDIVISION LOCATED IN THE NW 1/4 OF SECTION 27,  
TOWN 1 NORTH, RANGE 16 EAST, WALWORTH COUNTY, WISCONSIN



Parcel 1: Lot 2, Indian Prairie Subdivision, located in the Northwest 1/4 and Northeast 1/4 of the Northwest 1/4 of Section 27, Township 1 North, Range 16 East. Said land being in the Village of Walworth, County of Walworth, State of Wisconsin.

Parcel 2: An undivided 1/54 interest in Outlots 1 and 2, Indian Prairie Subdivision, located in the Northwest 1/4 and Northeast 1/4 of the Northwest 1/4 of Section 27, Township 1 North, Range 16 East. Said land being in the Village of Walworth, County of Walworth, State of Wisconsin.

Tax Key No: VIP 00002

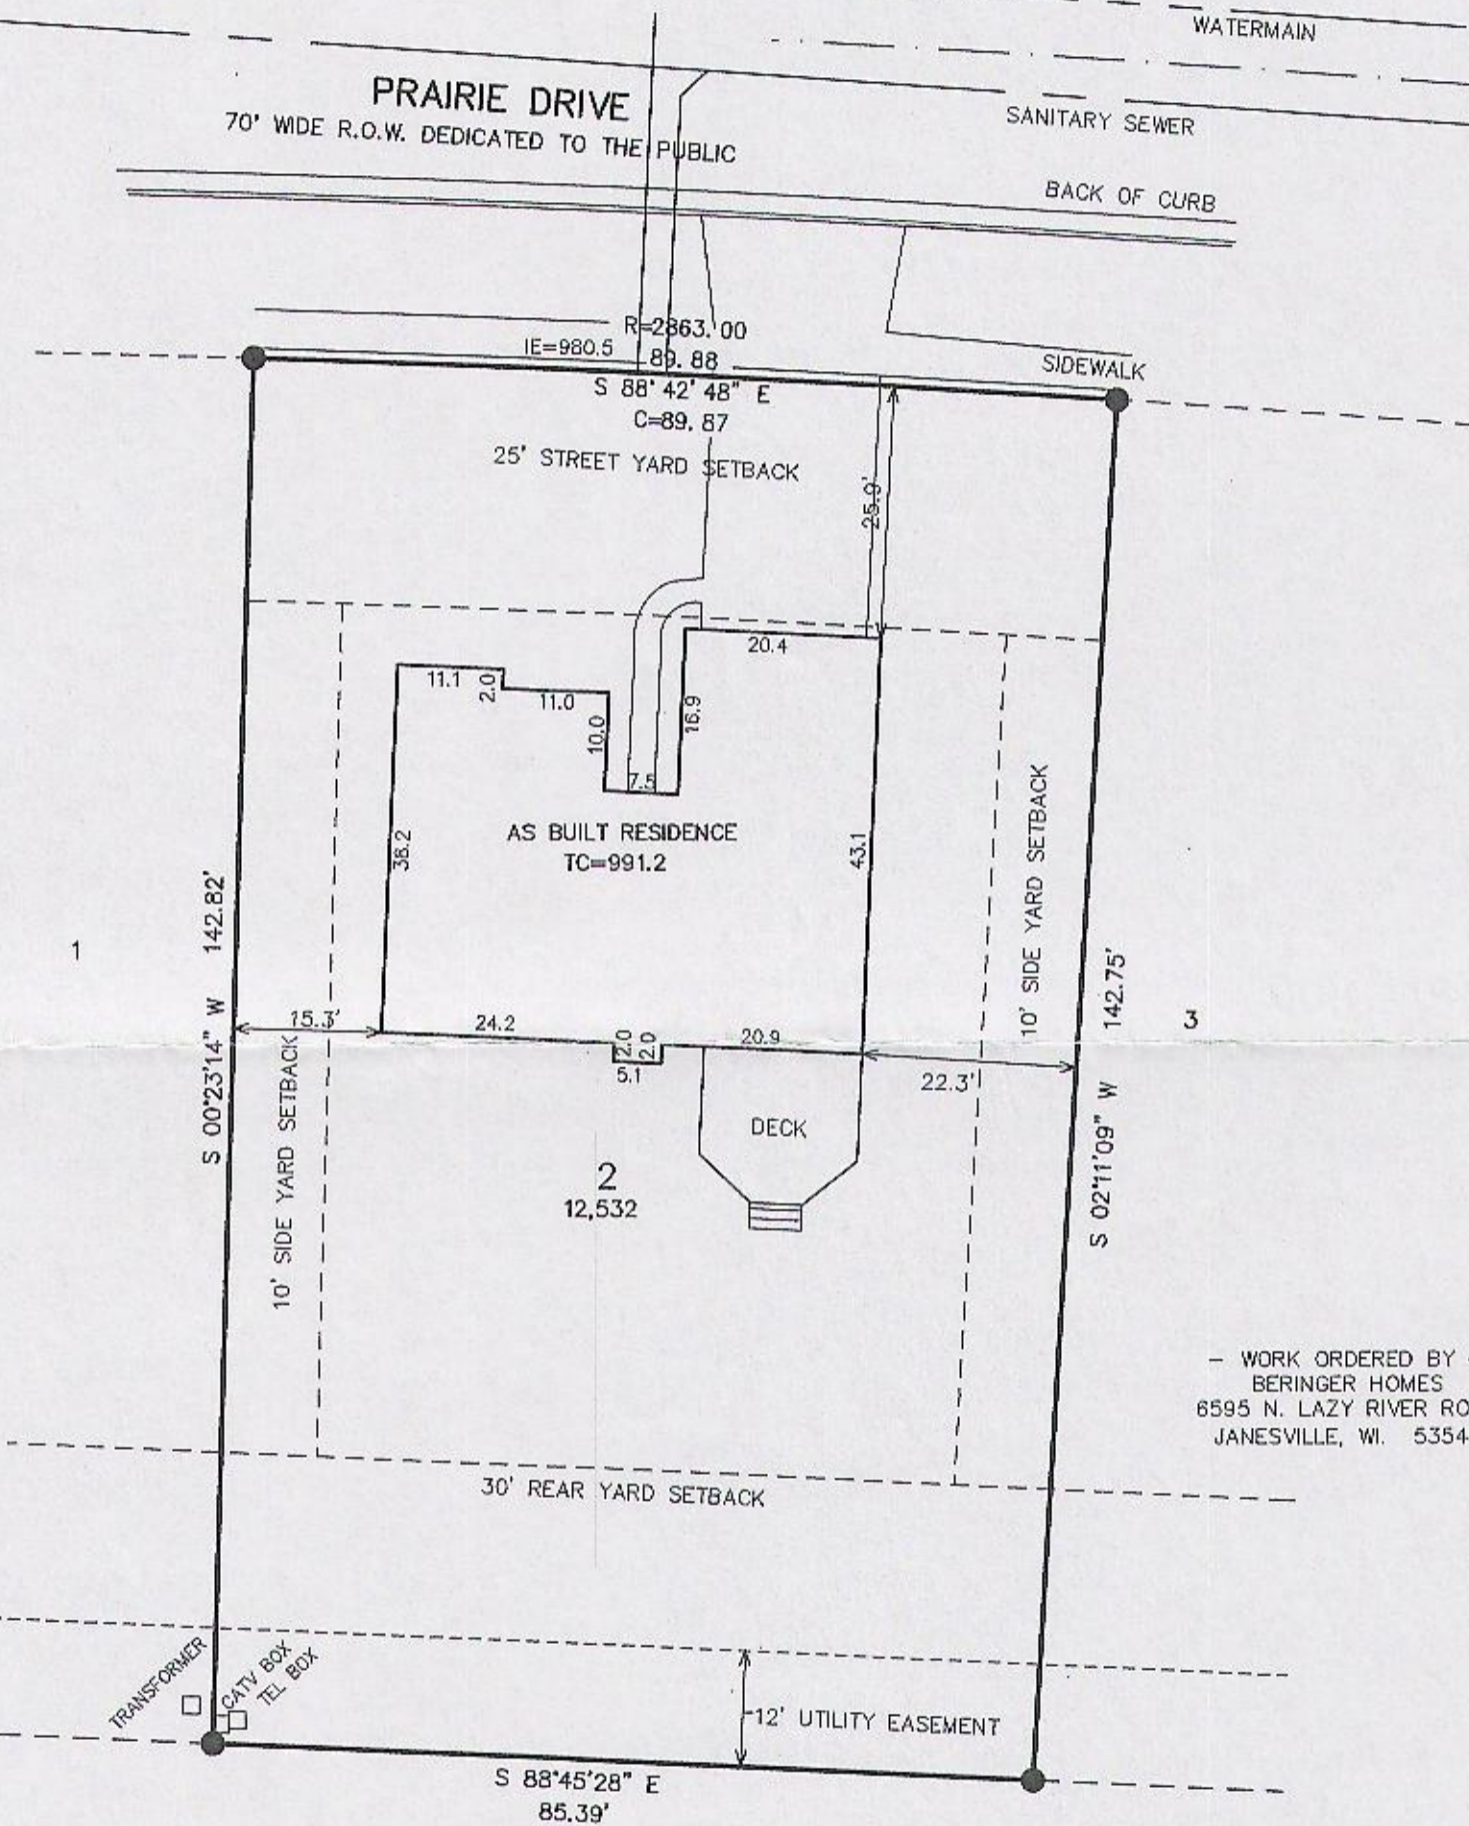

— WORK ORDERED BY —  
BERINGER HOMES  
6595 N. LAZY RIVER ROAD  
JANESVILLE, WI. 53545

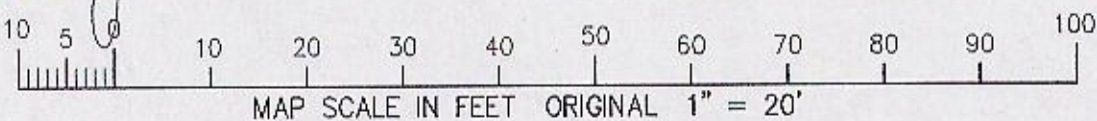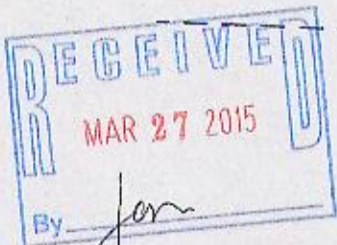

NOTE: COPIES OF THIS MAP TO WHICH THE FOLLOWING CERTIFICATE WILL APPLY SHOW SURVEYOR'S ORIGINAL SEAL AND SIGNATURE IN RED INK. COPIES BY ANY OTHER MEANS MAY HAVE ALTERATIONS WHICH DO NOT REPRESENT THE SURVEYOR'S WORK PRODUCT.

I HEREBY CERTIFY THAT THE ABOVE DESCRIBED PROPERTY HAS BEEN SURVEYED UNDER MY DIRECTION AND THAT THE ABOVE MAP IS A TRUE REPRESENTATION THEREOF AND SHOWS THE SIZE AND LOCATION OF THE PROPERTY, ITS EXTERIOR BOUNDARIES, THE LOCATION OF ALL VISIBLE STRUCTURES, AND DIMENSIONS OF ALL PRINCIPLE BUILDINGS THEREON, BOUNDARY FENCES, APPARENT EASEMENTS, ROADWAYS, AND VISIBLE ENCROACHMENTS, IF ANY. THIS SURVEY IS MADE FOR THE USE OF THE PRESENT OWNERS OF THE PROPERTY, AND ALSO THOSE WHO PURCHASE, MORTGAGE, OR GUARANTEE THE TITLE THERETO WITHIN ONE YEAR FROM THE DATE HEREOF.

DATED: SEPTEMBER 16, 2009

REVISED 01-04-2010 TO SHOW  
AS BUILT RESIDENCE  
REVISED & RESURVEYED 03-16-2015

*Peter S. Gordon*  
PETER S. GORDON R.L.S. 2101



PROJECT: 5189.02  
DATE: 09/16/2009  
SHEET 1 OF 1