
## Engineering, Incorporated 1316 North Madison Street, Woodstock, Illinois (815) 337-8310 www.vandersinc.com

## PLAT OF SURVEY

Lot 9 Clarke's Second Addition to the Village of Walworth.

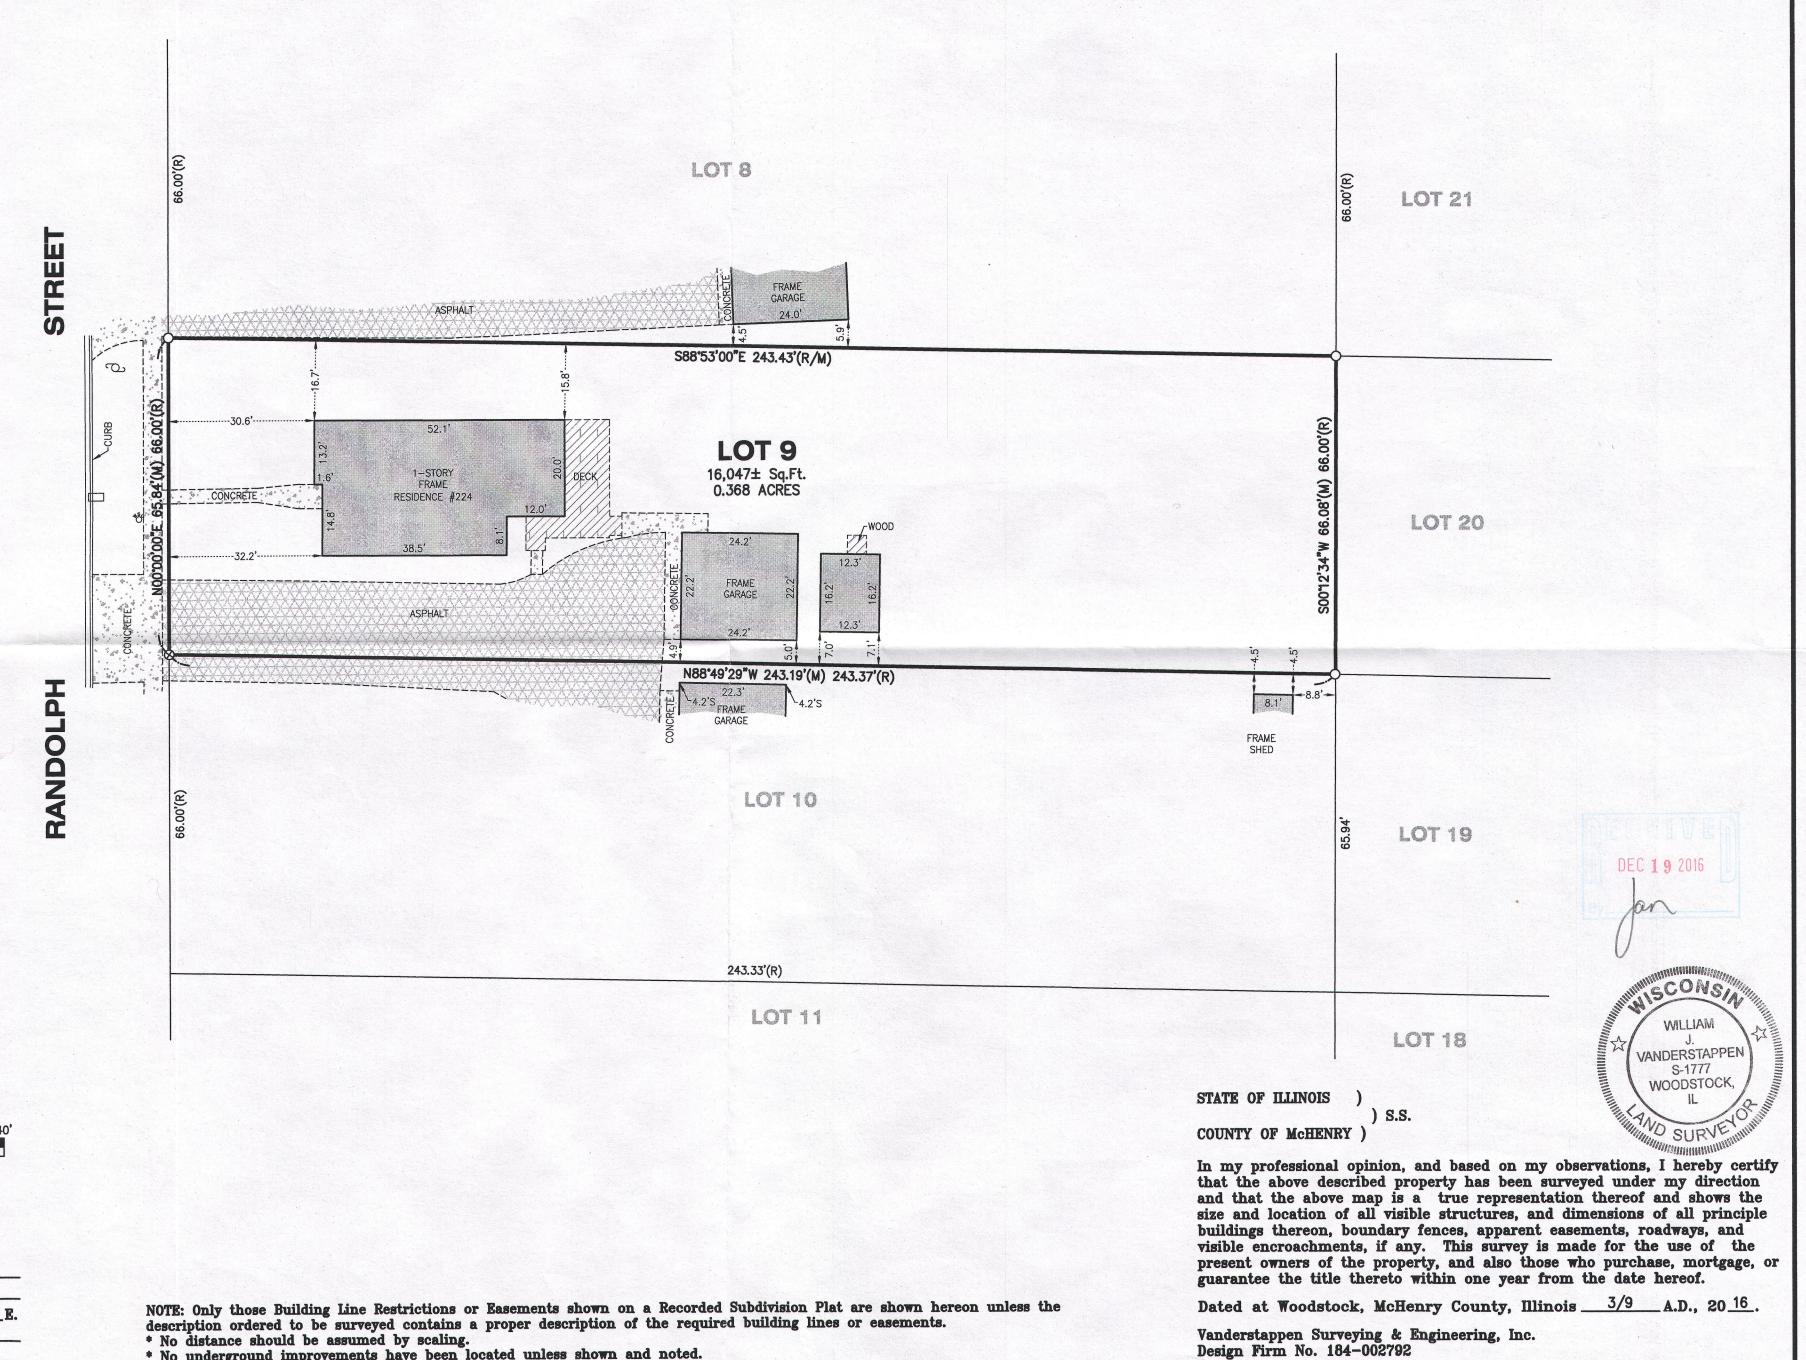

CLIENT: RAULAND AGENCY

CHECKED BY: WJV DRAWN BY: SES SCALE: 1"=20' SEC. 22 T. 1 R. 15 E.

SCALE: 1" = 20'

**LEGEND**  FOUND IRON BAR O FOUND IRON PIPE ⊗ FOUND MAG NAIL

☐ MAIL BOX

(D) DEED

(R) RECORD

(M) MEASURE

O UTILITY POLE \* WATER SHUT-OFF

BASIS OF BEARING: ASSUMED

P.I.N.: VCA200011 I.D. LSS JOB NO.: 160097

FIELDWORK COMP.: 3/8/16 BK. PG. ALL DISTANCES SHOWN IN FEET AND DECIMAL REF: ...

\* No underground improvements have been located unless shown and noted.

\* No representation as to ownership, use, or possession should be hereon implied.

\* This Survey and Plat of Survey are void without original embossed or colored seal and signature affixed.

Compare your description and site markings with this plat and AT ONCE report any discrepancies which you may find.

VCA2-11 009-1267

Wisconsin Registered Land Surveyor No. S1777