


PLAT OF SURVEY

OF

A parcel of land located in the Southeast $\frac{1}{4}$ of Section 16, Town 1 North, Range 16 East, Walworth County, Wisconsin, more particularly described as follows: Commencing at the Southeast corner of said Section 16; thence North $0^{\circ}22'53''$ West, 774.71 feet along the East line of said Section 16; thence North $89^{\circ}21'30''$ West, 385.00 feet to an iron rod and the point of beginning; thence continue North $89^{\circ}21'30''$ West, 377.25 feet to an iron rod on the East line of a 66 foot road; thence North $0^{\circ}39'00''$ East, 410.48 feet along the East line of said road to an iron pipe on the South line of Wisconsin Street; thence South $89^{\circ}25'30''$ East, 369.84 feet along the South line of Wisconsin Street to an iron rod; thence South $0^{\circ}22'57''$ East, 410.98 feet to the point of beginning.

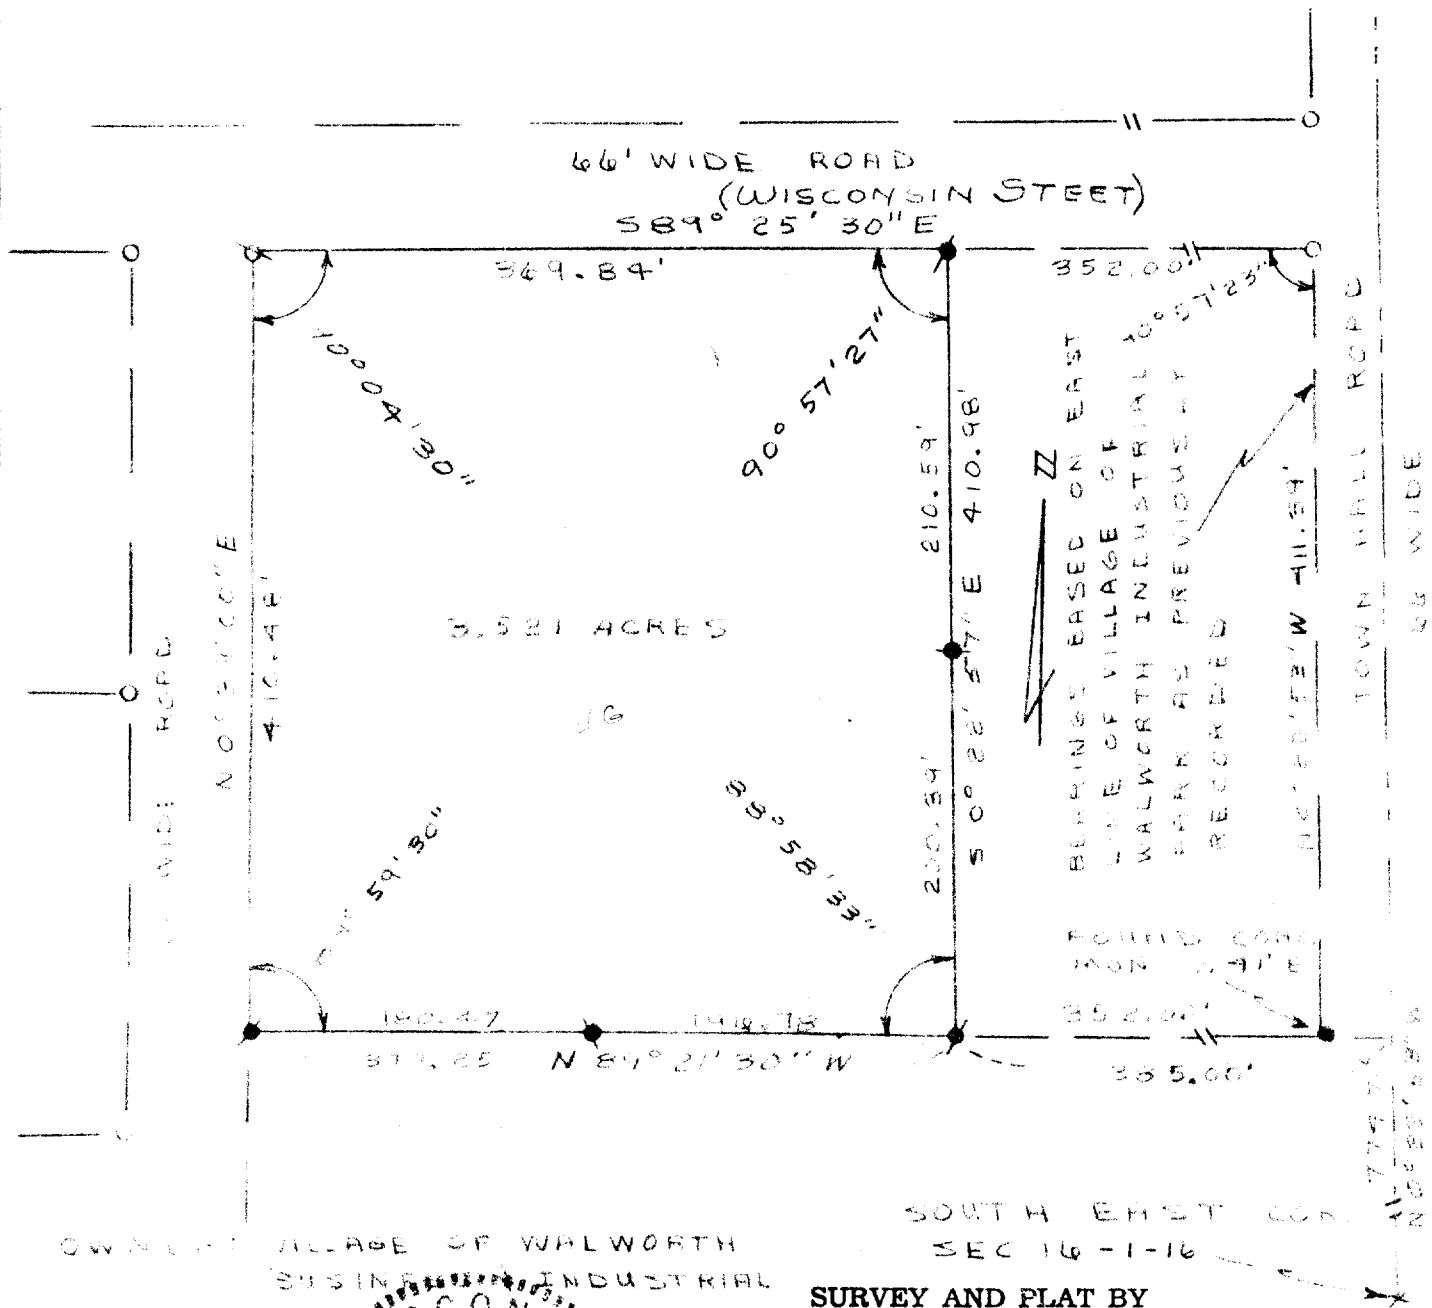

OWNERS: VILLAGE OF WALWORTH
BUSINESS INDUSTRIAL
CORPORATION

SURVEY AND PLAT BY

JENSEN & JOHNSON, INC.

CIVIL ENGINEERS AND SURVEYORS

Elkhorn, Wisconsin

LEGEND

○ — Iron Pipe

● — Concrete Monument

Scale 1" = 100'

WE CERTIFY: That we have surveyed the above described property and that the plat shown hereon is an accurate survey and a true representation thereof and correctly shows the exterior boundary lines and all divisions of said property.

Date DEC 10 1975

THOMAS P. A. JENSEN
Wisconsin Registered Land Surveyor, No. 5-1084