

Wisconsin Professional Land Surveyor S-2582

**N9330 Knuteson Drive
Whitewater, WI 53190
Phone:(262)949-1239
MARKMIRITZ@
LAND-MARKSURVEYING.COM**


LEGAL DESCRIPTION

Beginning at the intersection of the Southeasterly line of Outlot 32 of the Assessor's Plat of the Village of Walworth with the Southwesterly line of Madison Street, in said Village of Walworth; then South 44°00'00" East, along the Southwesterly line of said Madison Street, 82.50 feet; thence South 45°52'00" West, 181.59 feet; thence South 88°55'06" West, 22.19 feet; thence North 44°00'00" West, 67.00 feet, to the Southeasterly line of said Outlot 32; thence North 45°48'24" East, along said Southeasterly line, 198.00 feet, to the place of beginning.

(66' WIDE)

**OWNER:
PATRICK ONEILL
31138 DANIELS DR.
GENOA, IL. 60135**

RECEIVED
JAN 25 2022
By zmf

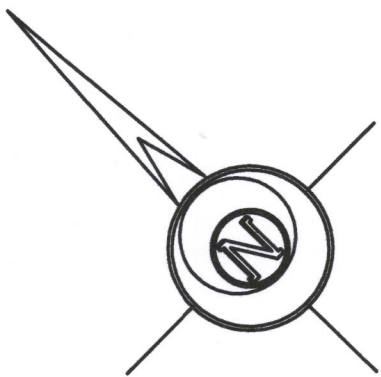

BASIS OF BEARINGS:
THE SOUTHWESTERLY LINE OF MADISON ST.
BEING S 44°00'00" E

OUTLOT 32

LEGEND

 **FOUND IRON PIPE**
 **RECORDED AS DIMENSION**
 **EXISTING FENCE**

SCALE: 1 INCH = 20 FEET

"I hereby certify that the above described property has been surveyed by me or under my direction and that the above map is a true representation thereof and shows the size and location of the property, its exterior boundaries, the location of all visible structures and dimensions of all principal buildings thereon, boundary fences, apparent easements, roadways and visible encroachments, if any."

"This survey is made for the use of the present owners of the property, and also those who purchase, mortgage, or guarantee the title thereto within one year from date hereof."

MARK L. MIRITZ
WISCONSIN PROFESSIONAL
LAND SURVEYOR S-2582

DATE: DEC. 17, 2021 **JOB NO.** 21.1203

WISCONSIN

MARK L.
MIRITZ
S-2582
WHITEWATER,
WI

LAND SURVEYOR

TAX PARCEL
VOP 00019
16,182 SQ. FT.

VOP-19

009-1362