


SURVEYING & SUBDIVIDING
DELAN, WISCONSIN 53115

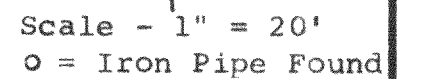

I, James M. Dunham, Surveyor, certify that I have surveyed the property described as follows, Outlot 165 of the Assessor's Plat of the Village of Walworth, Walworth County, Wisconsin, and that the above map is a true representation thereof and shows the size and location of the property, its exterior boundaries, the location of all visible structures and dimensions of all principal buildings thereon, boundary fences, apparent easements, roadways and visible encroachments, if any. This survey is made for the use of the present owners of the property, and also those who purchase, mortgage, or guarantee the title thereto within one (1) year from date hereof.

July 26, 1979

A circular seal for a Wisconsin Land Surveyor. The outer ring contains the text "WISCONSIN" at the top and "LAND SURVEYOR" at the bottom, separated by two five-pointed stars. The inner circle contains the text "JAMES M. DUNHAM", "S-1331", and "DELAVAN, WIS." arranged vertically.