HOME OFFICE 109 BOUTH SPRING STREET BURLINGTON, WISCONSIN 53108 PHONE: 414-763-2652 414-763-7834

ROBERS & BOYD, INC.

CONSULTING ENGINEERS
LAND SURVEYORS

BRANCH OFFICE 809 - 43RD STREET KENOSHA, WISCONSIN 53140 PHONE: 414-658-4488

MORTGAGE INSPECTION FOR


UNIVERSAL MORTGAGE CORP.

OF

Outlot 164 of the Assessor's Plat to the Village of Walworth, Walworth County, Wisconsin.

Buyer: Donald & Arlene Arntz

213 High Street Walworth, WI

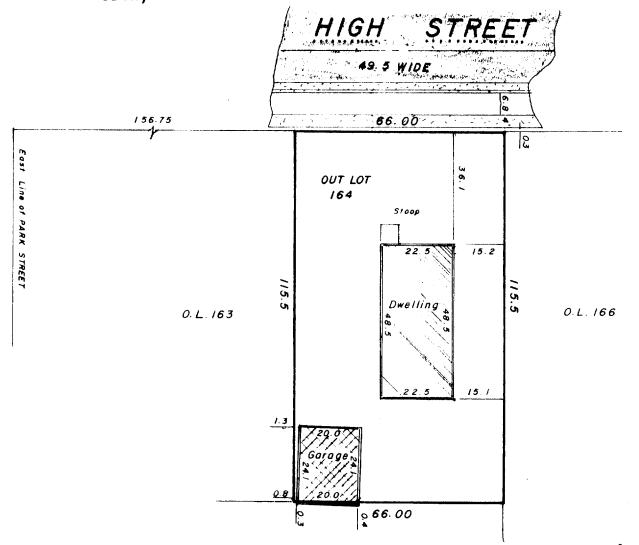

O.L. 165

NOTE: This Mortgage Inspection was prepared for identification purposes for a real estate sale transaction. No corners were set by request of Universal Mortgage Corp.. Do not use this map for establishing fence lines or construction.

"I hereby certify that I have surveyed the above described property and that the above map is a true representation thereof and shows the size and location of the property, its exterior boundaries, the location of all visible structures and dimensions of all principal buildings thereon, boundary fences, apparent easements, roadways and visible encroachments, if any.

"This survey is made for the use of the present owners of the property, and also those who purchase, mortgage, or guarantee the title thereto within one year from date hereof."

YES TO MONUMENTATION HAS BEEN WAIVED IN ACCORDANCE WITH A-E 5.01(b) OF THE WISCONSIN ADMINISTRATIVE CODE.

KENNETH R.
RLESMAN
S. 1951
BURL LLION

FIELD WORK BY

LEGEND
PK NAIL FOUND
PK NAIL SET
FOUND IRON PIPE -

FOUND IRON PIPE -SET IRON PIPE -FOUND BRASS CAPPED MONUMENT FOUND CONCRETE MONUMENT

FENCE

() RECORDED AS

EXISTING GROUND ELEVATION

SCALE-1" = 30

82133

WISCONSIN REGISTERED LAND SURVEYOR

8/30/82 DATE

00488

JOB NUMBER