


NORTHWEST CORNER OF THE
SW¹/₄ OF THE SW¹/₄ OF SECTION 22

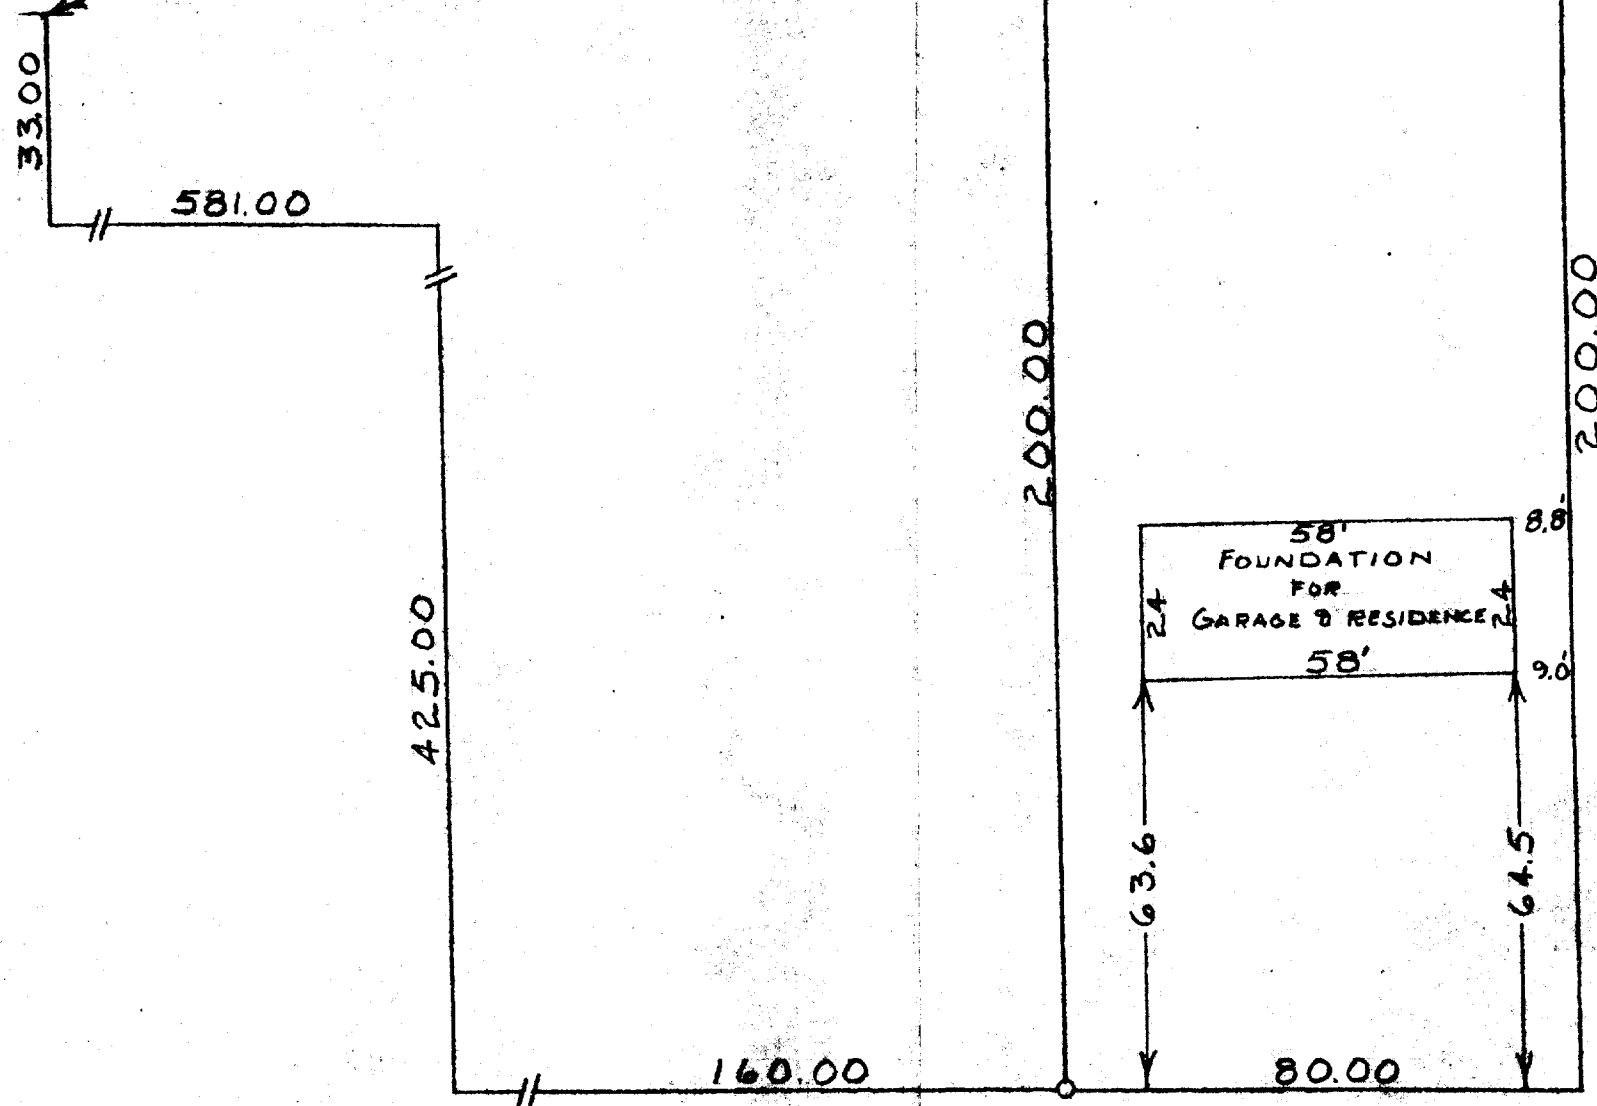

SCALE-1"=30'
0=IRON PIPE

STATE OF WISCONSIN
WALWORTH COUNTY

I, GEORGE T. DUNHAM, DO HEREBY CERTIFY THAT I HAVE SURVEYED THE PROPERTY DESCRIBED AS FOLLOWS:

A PARCEL OF LAND LOCATED IN THE SW¹/₄ OF THE SW¹/₄ OF SECTION 22, TIRIUE, VILLAGE OF WALWORTH, WALWORTH COUNTY, WISCONSIN DESCRIBED AS FOLLOWS, TO-WIT: COMMENCING AT THE NW CORNER OF THE SW¹/₄ OF THE SW¹/₄ OF SAID SECTION 22; THENCE SOUTH ALONG THE WEST LINE OF SAID SECTION 33.00 FEET; THENCE EAST PARALLEL WITH THE EAST-WEST ¹/₈TH SECTION LINE OF SAID SOUTHWEST ¹/₄ 581.00 FEET; THENCE SOUTH PARALLEL WITH THE WEST LINE OF SAID SECTION 22, 425.00 FEET; THENCE EAST PARALLEL WITH THE EAST-WEST ¹/₈TH SECTION LINE 160.00 FEET TO THE PLACE OF BEGINNING; THENCE NORTH PARALLEL TO THE WEST LINE OF SAID SECTION 200.00 FEET; THENCE EAST PARALLEL WITH SAID E-W ¹/₈TH SECTION LINE 80.00 FEET; THENCE SOUTH PARALLEL WITH THE WEST LINE OF SAID SECTION 200.00 FEET; THENCE WEST 80.00 FEET TO THE PLACE OF BEGINNING.

AND THAT THE PLAT SHOWN ABOVE IS A CORRECT REPRESENTATION OF THE PROPERTY LINES AND OF THE IMPROVEMENTS LOCATED THEREON
JAN. 20, 1959

George T. Dunham
GEORGE T. DUNHAM, SURVEYOR 9-20
DELAVER, WISCONSIN