

Farris, Hansen & Associates, Inc.


Engineering, Surveying & Land Planning

P.O. BOX 487

715 W. WALWORTH STREET
ELKHORN, WISCONSIN 53121

PLAT of SURVEY
OF

The South 57.5 feet of the North 115.5 feet of the West 132 feet
of Outlot 156, Assesors Plat, Village of Walworth, Walworth Co., Wisc.

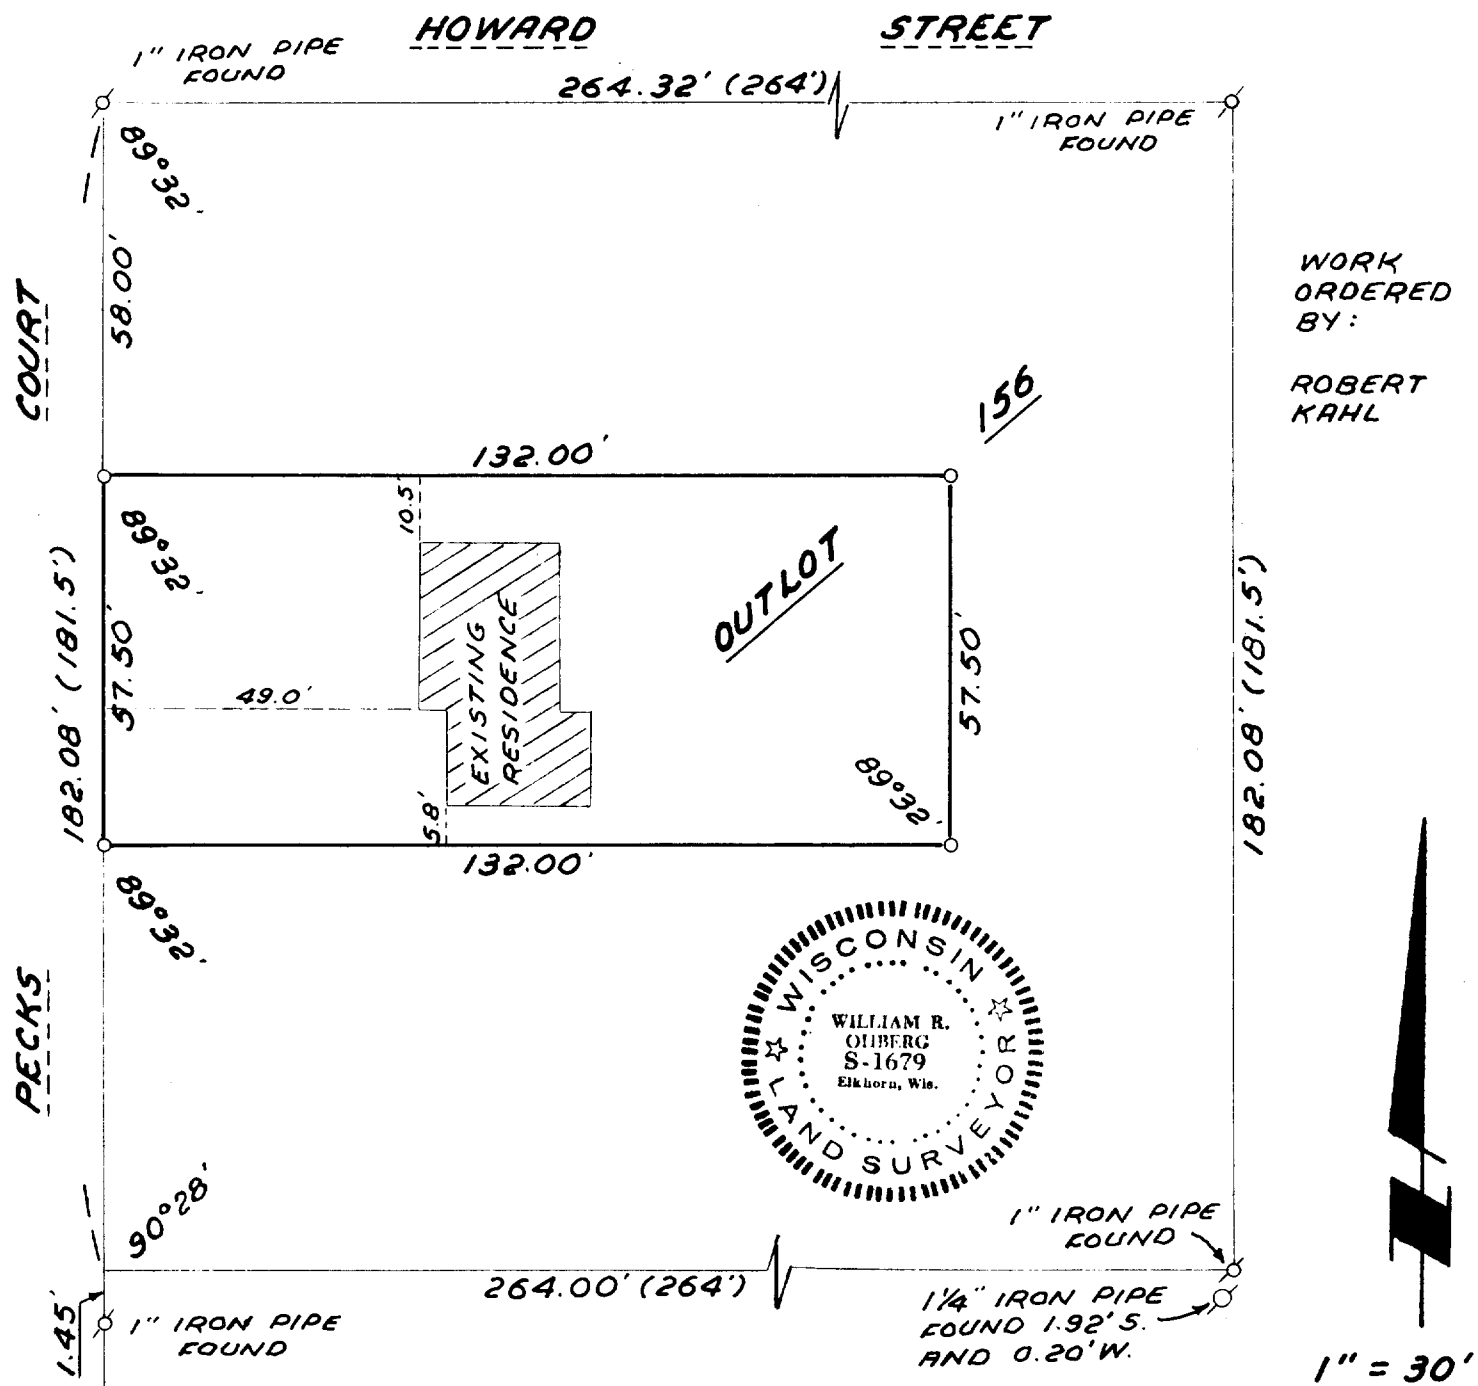

I hereby certify that I have surveyed the above described property and that this plat is a true and accurate representation thereof to the best of my professional knowledge and belief.

William R. Ohberg RLS No. 1679

dated this 17th day of Feb., 1983

vwp-180

William R. Ohberg

LEGEND

○ — 1" IRON PIPE SET

() — RECORD DIMENS.

PROJECT NO. 2053

9-202-F