
DUNHAM SURVEYING, S. C. SURVEYING & SUBDIVIDING DELAYAN, WISCONSIN 53115

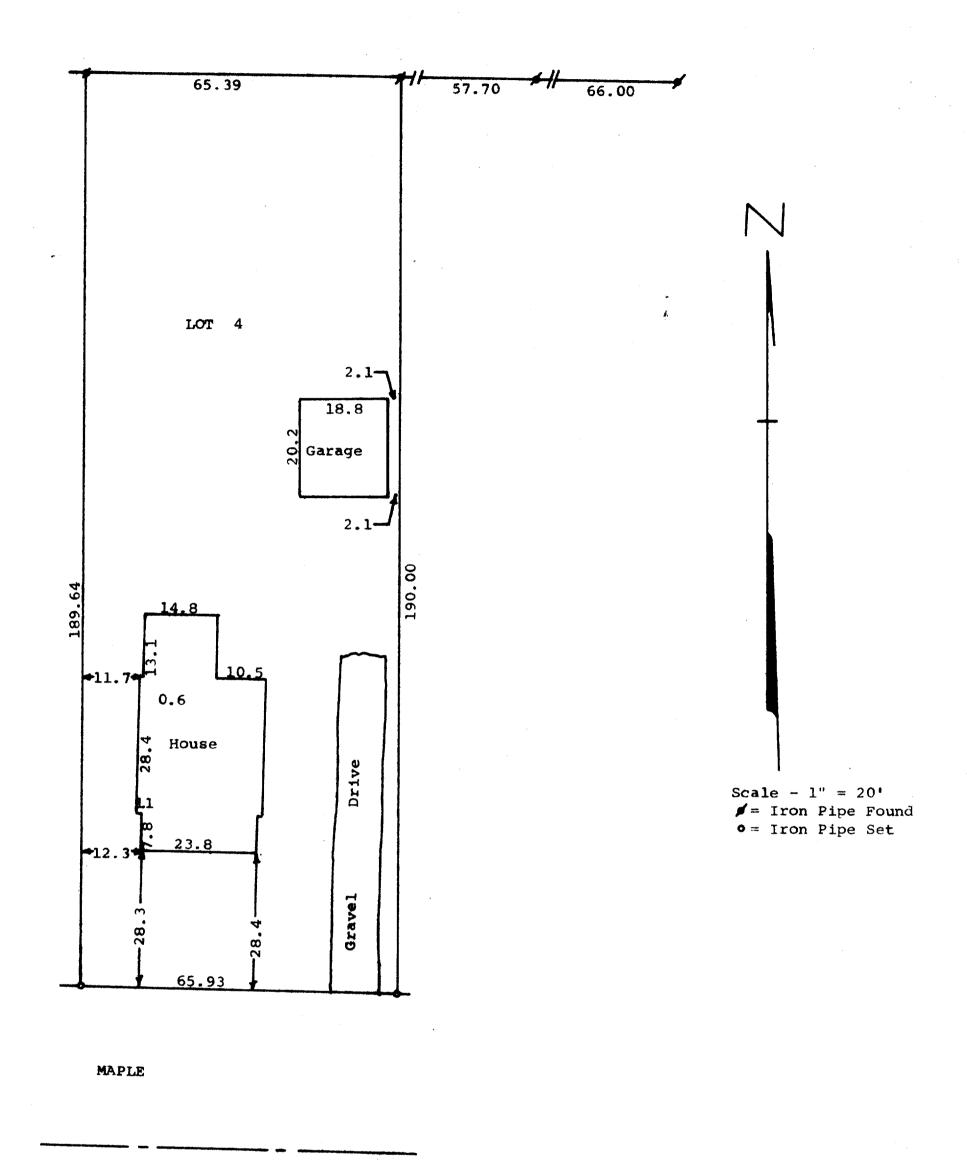

AVENUE

STATE OF WISCONSIN) COUNTY OF WALMORTH) SS

COUNTY OF WALMORTH) SS

I, George T. Dunham, Surveyor, certify that I have surveyed the property described as follows:

Lot 4 in Clarke's Addition to the Village of Walworth, Walworth County, Wisconsin,

and that the above map is a true representation thereof and shows the size and location of all visible structures and dimensions of all principal buildings thereon, boundary fences, apparent easements, roadways and visible encroachments, if any.

This survey is made for the use of the present owners of the property, and also those who purchase, mortgage, or guarantee the title thereto within one (1) year from date hereof.

March 12, 1980

George T. Dunham, Surveyor

