


O = IRON PIPE STAKE FOUND
(xxx) = RECORD DIMENSION

MAP
SCALE
1" = 30'

EAST 264.32'
(264')

PLAT OF SURVEY OF THE SOUTH 57.5 FEET OF THE
NORTH 115.5 FEET OF THE WEST 132 FEET OF OUT-
LOT 156 OF THE ASSESSOR'S PLAT FOR THE VILLAGE
OF WALWORTH, WALWORTH COUNTY, WISCONSIN
WORK ORDERED BY: ROBERT KAHN

PECKS COURT

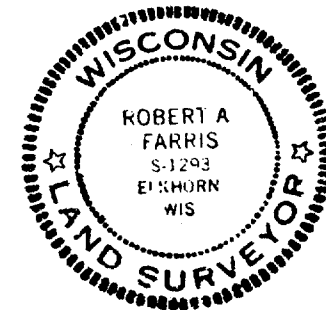

Robert A. Farnis
Jan 8, 1985

I hereby certify that I have surveyed the above described property and that the above map is a true representation thereof and shows the size and location of all buildings thereon, boundary fences, apparent easements, roadways and visible (approximately 1 foot snow cover) encroachments, if any. This survey is made for the use of the present owners of the property, and also those who purchase, mortgage, or guarantee the title thereto within one (1) year from the date hereof.

DRAWING NUMBER 2053.1

VWP-180

9-235 ✓