



DUNHAM SURVEYING, S.C.
SURVEYING & SUBDIVIDING
DELAVAN, WISCONSIN 53115

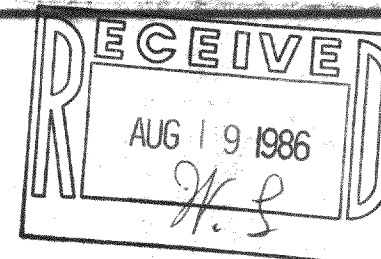

KENOSHA

STREET

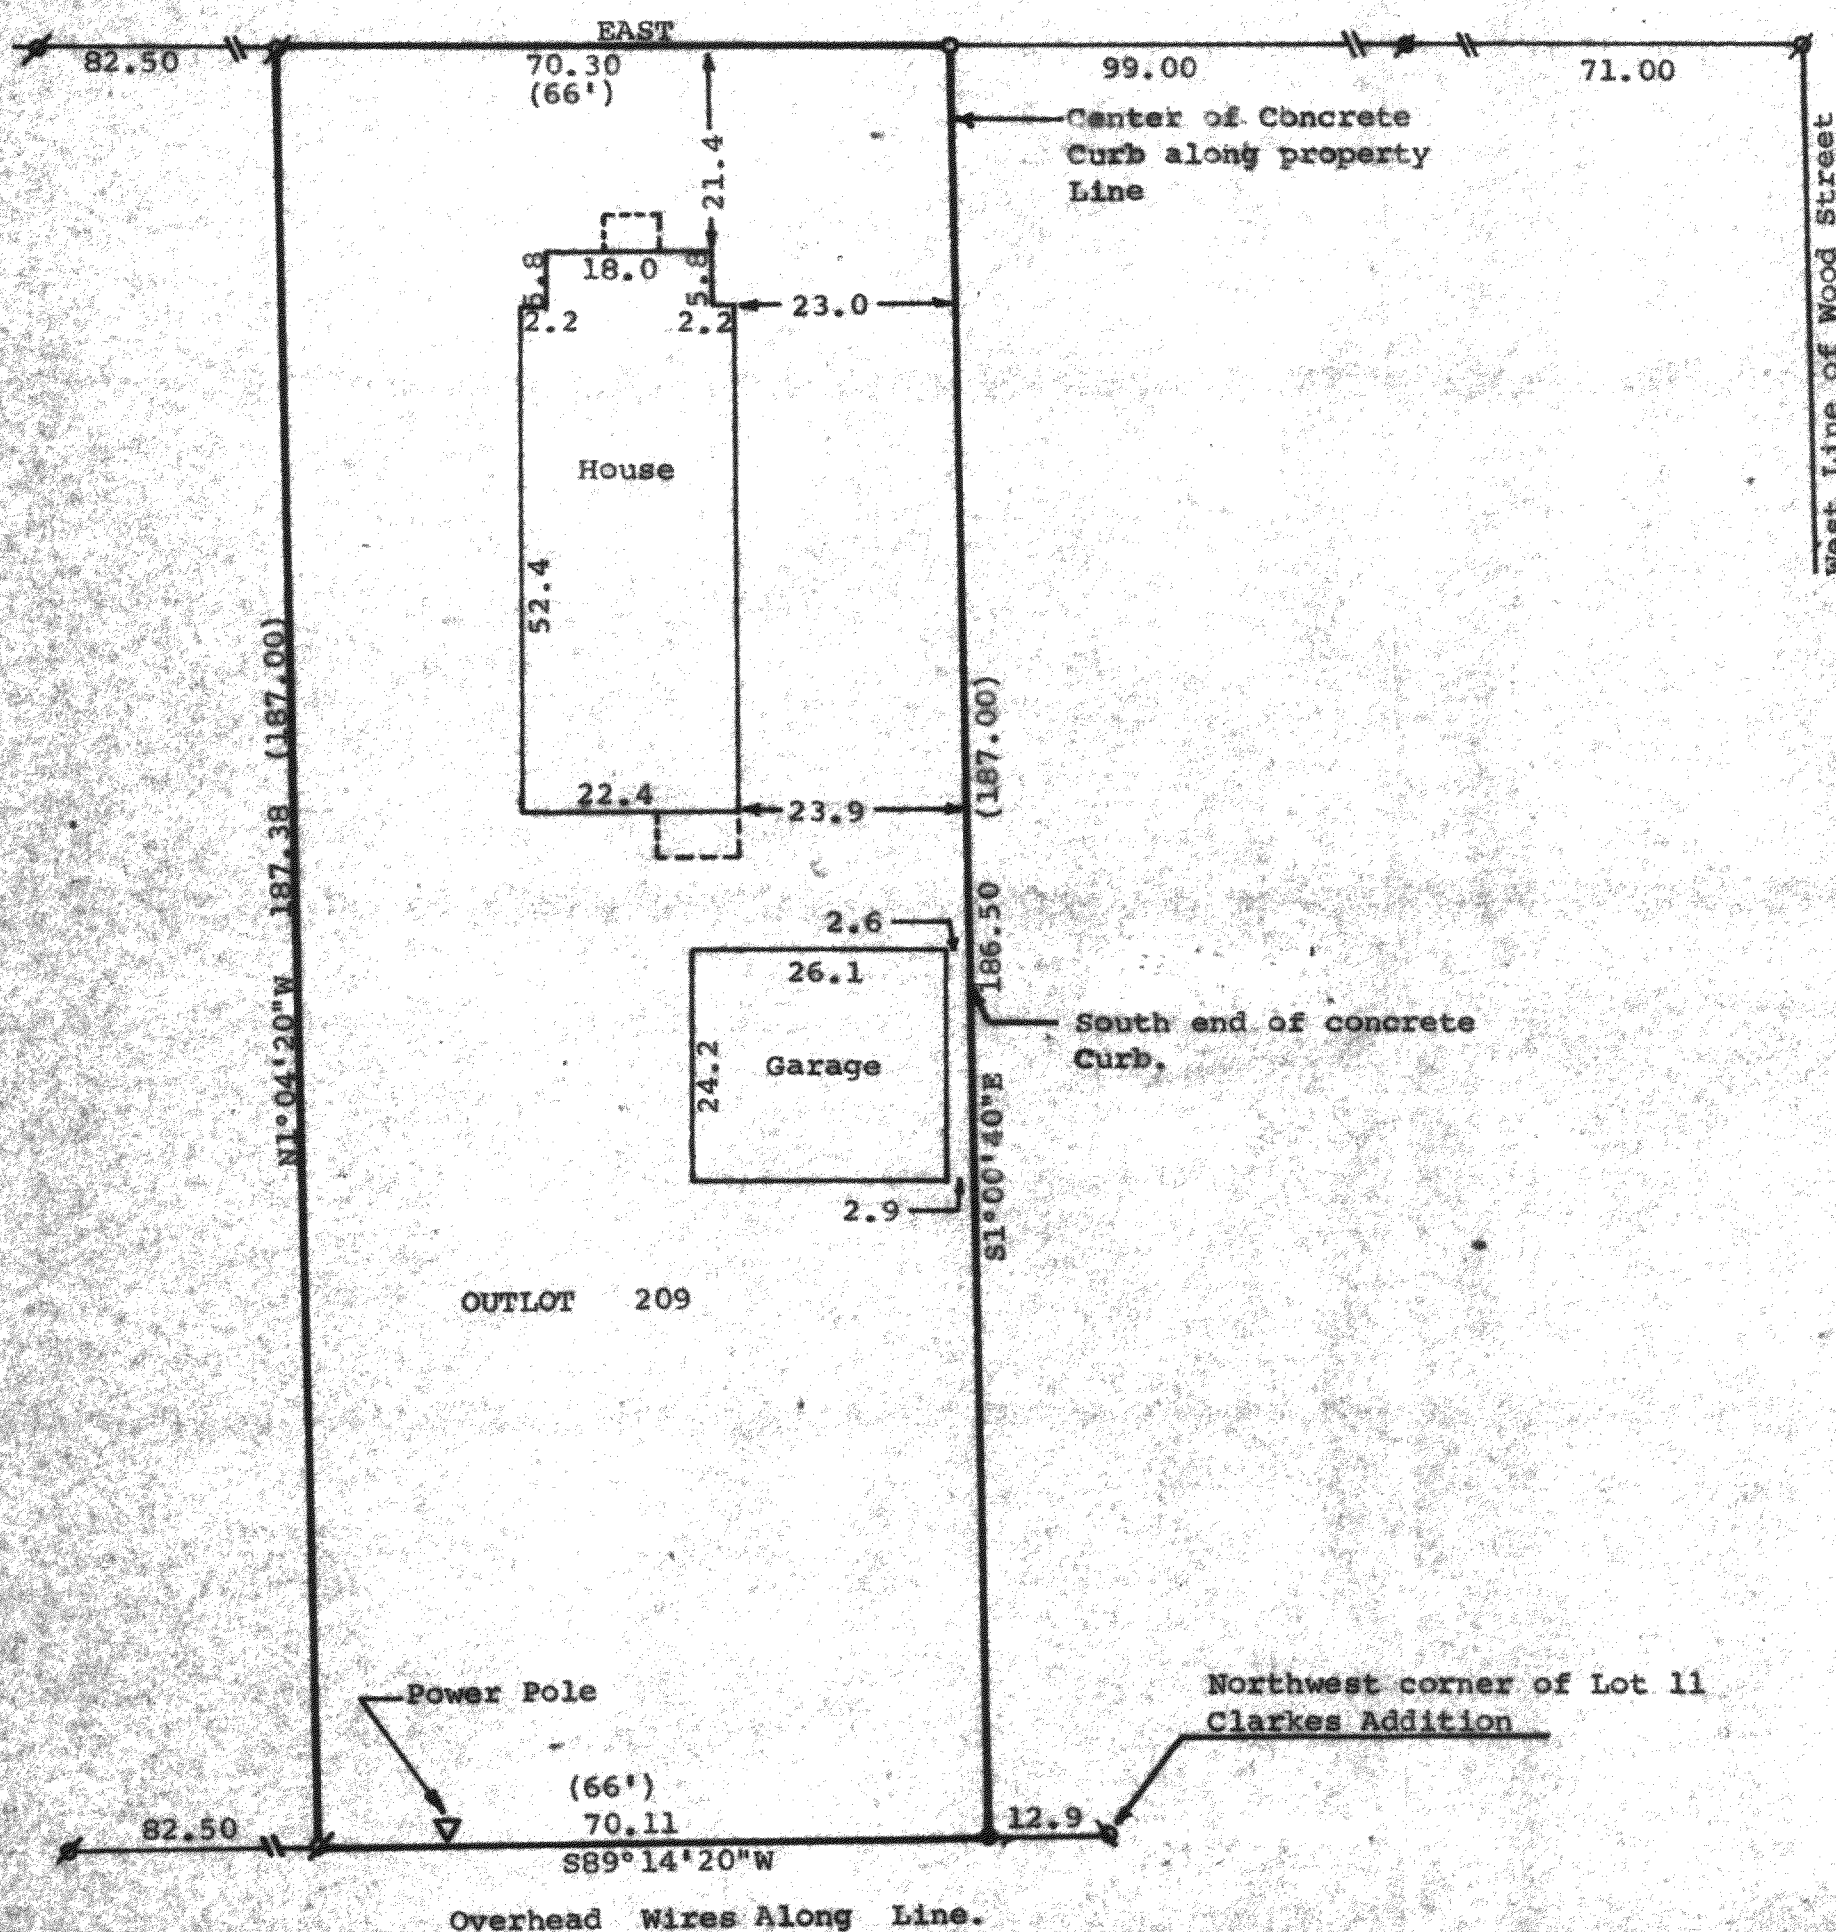

Scale - 1" = 20'
 ● = 3/4" Iron Pipe Found
 ○ = 1" Iron Pipe Found
 ● = 1 1/4" Iron Pipe Found
 ○ = 3/4" X 24" Iron Pipe Set
 (0.00) = recorded distance
 Bearings referenced to the south line of
 Kenosha Street with the assumed bearing of East
 Survey ordered by: Churchill Real Estate
 322 Park
 Walworth, WI 53184
 ● = 1/2" Iron Pipe Found

STATE OF WISCONSIN)
COUNTY OF WALWORTH) SS

I, George T. Dunham, Surveyor, certify that I have surveyed the property described as follows:

Outlot No. 209 of the Assessor's Plat in the Village of Walworth, Walworth County, Wisconsin.

and that the above map is a true representation thereof and shows the size and location of the property, its exterior boundaries, the location of all visible structures and dimensions of all principal buildings thereon, boundary fences, apparent easements, roadways and visible encroachments, if any, and that I have surveyed the property hereon described according to the official records, to the best of my knowledge and belief.
June 19, 1986

George T. Dunham
George T. Dunham, Surveyor

