
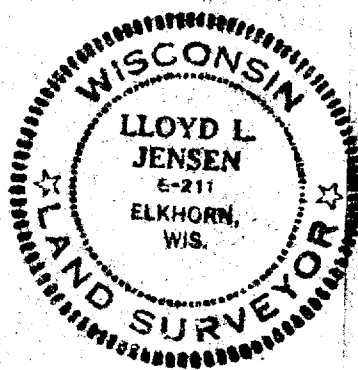


Kenosha Street

Reed Avenue

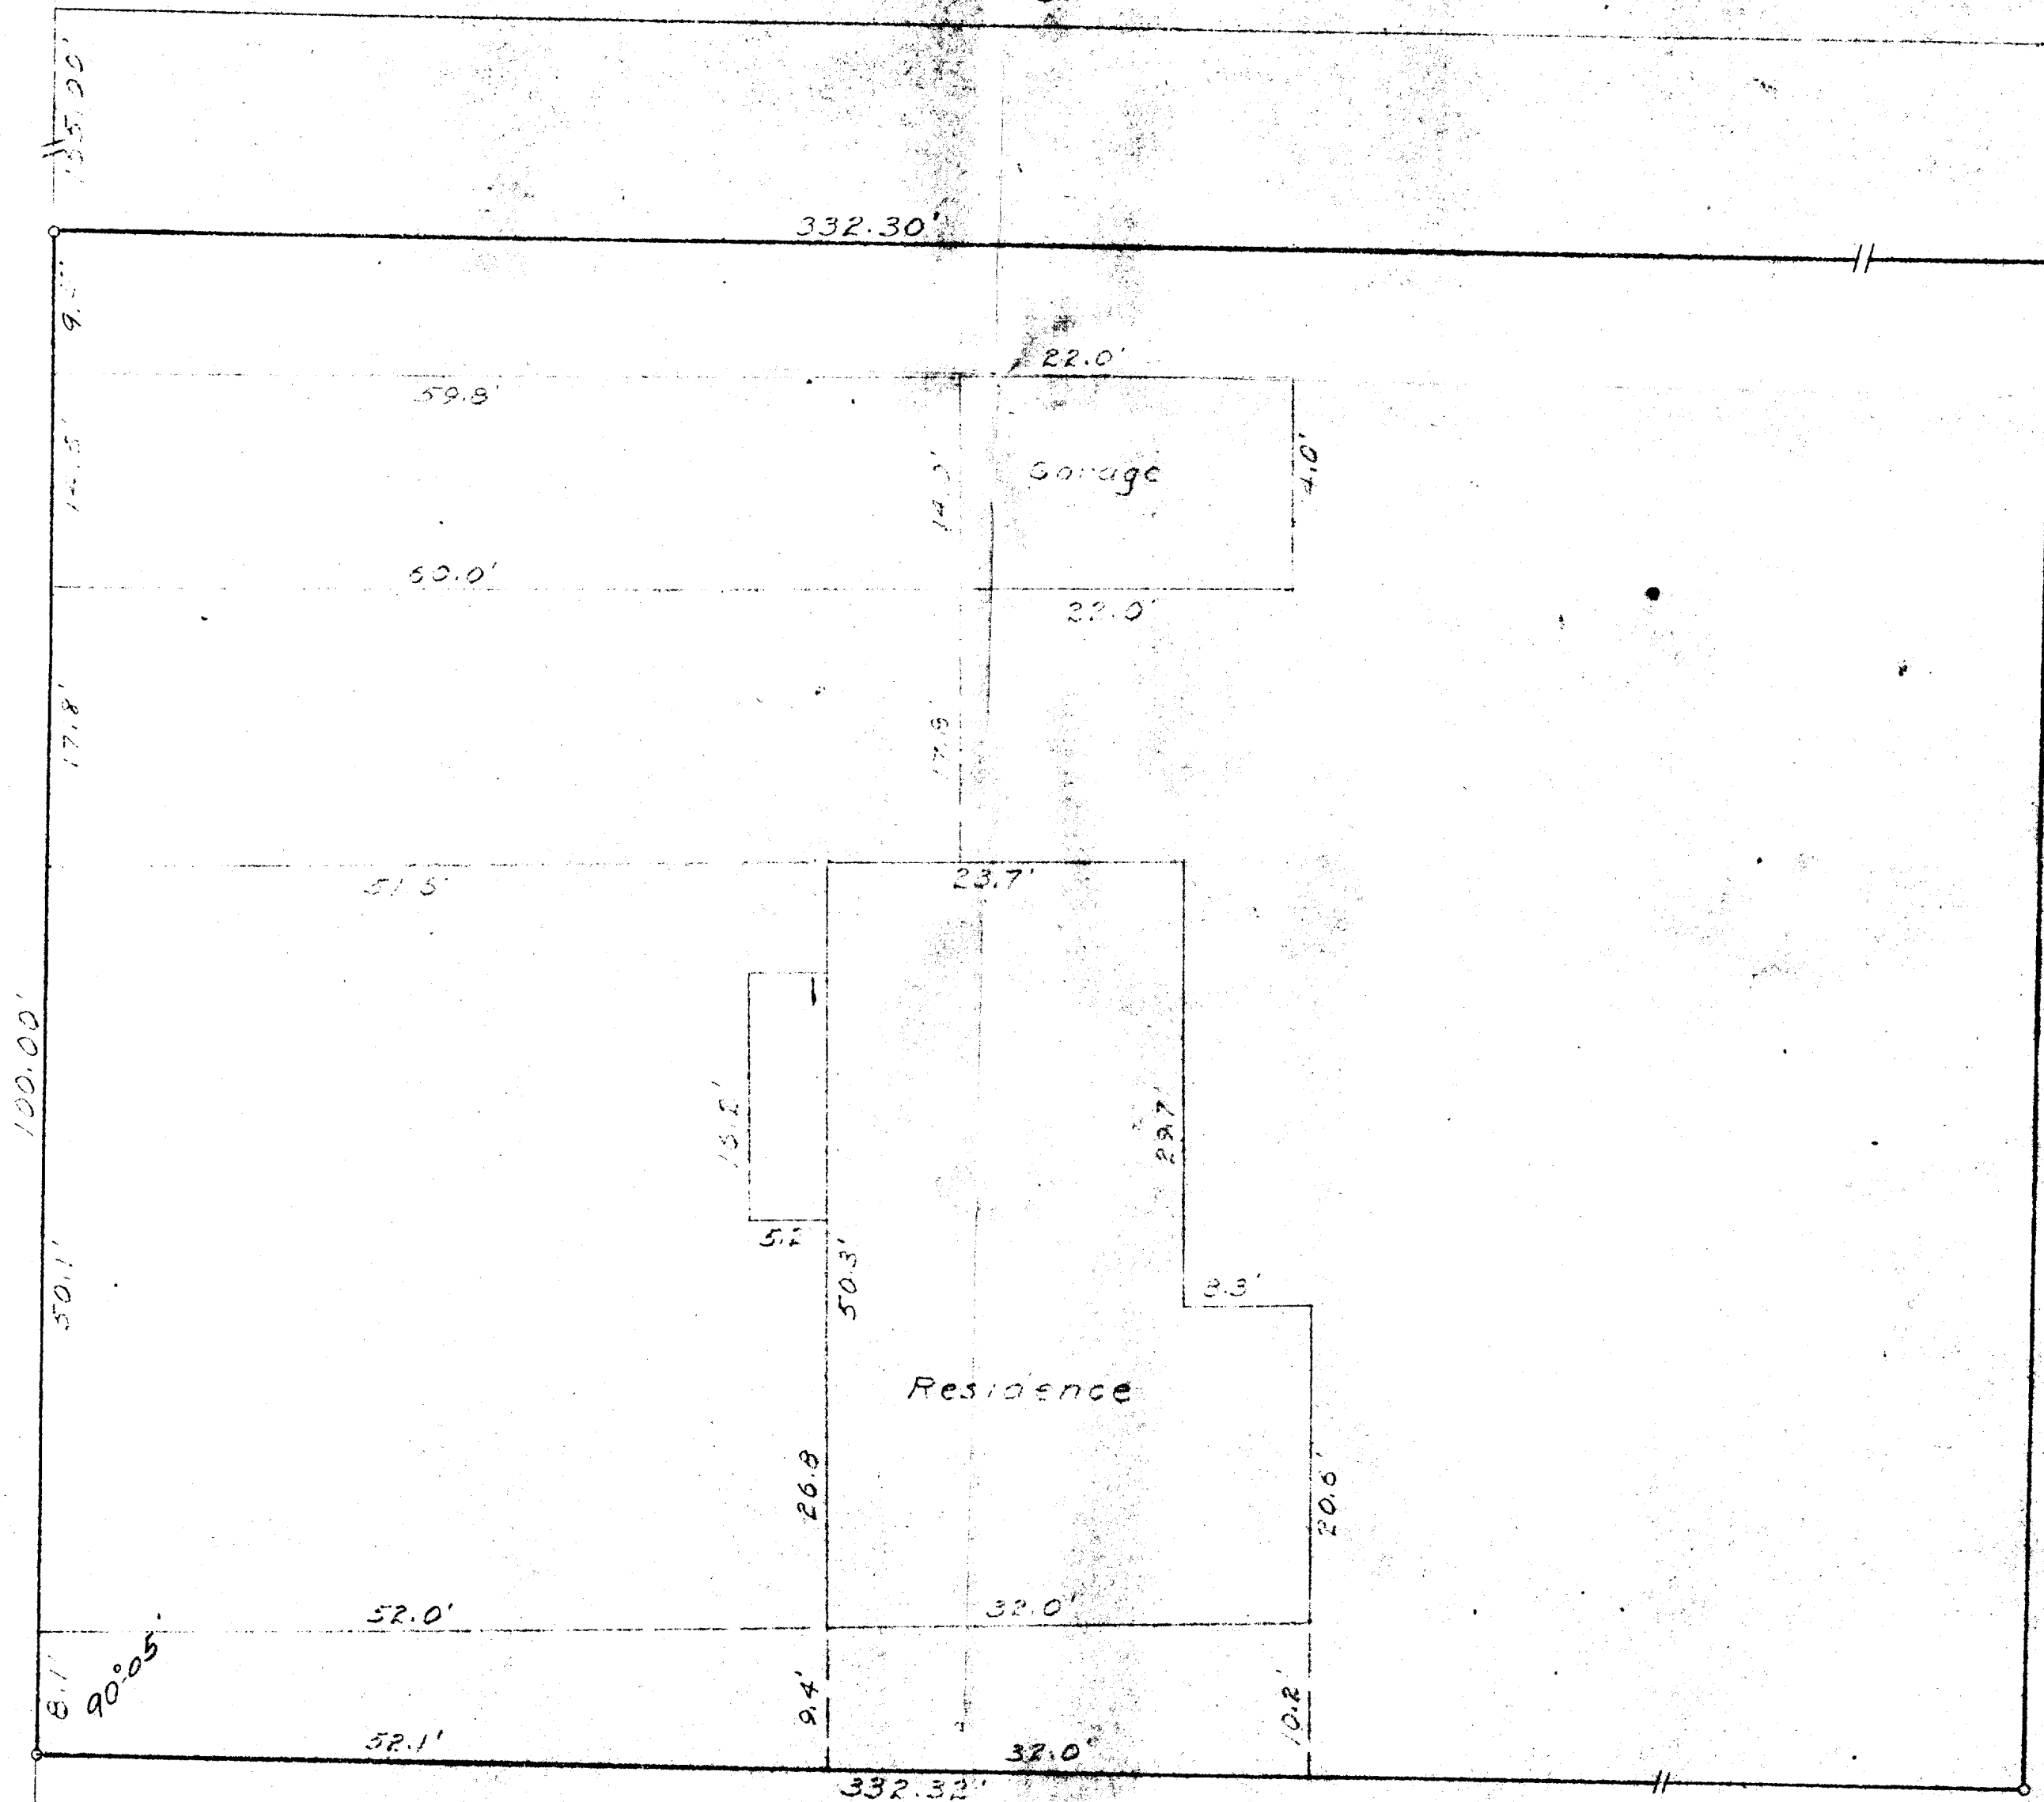

o- Iron Pipe

PLAT OF SURVEY
OF

Part of Outlot 218 of the
Village of Walworth, Walworth
County, Wisconsin

Lloyd L. Jensen

SCALE 1" = 10'

DATE Aug. 1950

VLP 293