


ABELL
SURVEYING & MAPPING
 DELAVAN, WISCONSIN 53115
 414-728-6737

POINT DESCRIBED AS BEING
 670.9 FEET NW OF THE 1/4 POST
 BETWEEN SECTIONS 21 AND 22,
 T1N,R16E, WALWORTH COUNTY, WI.

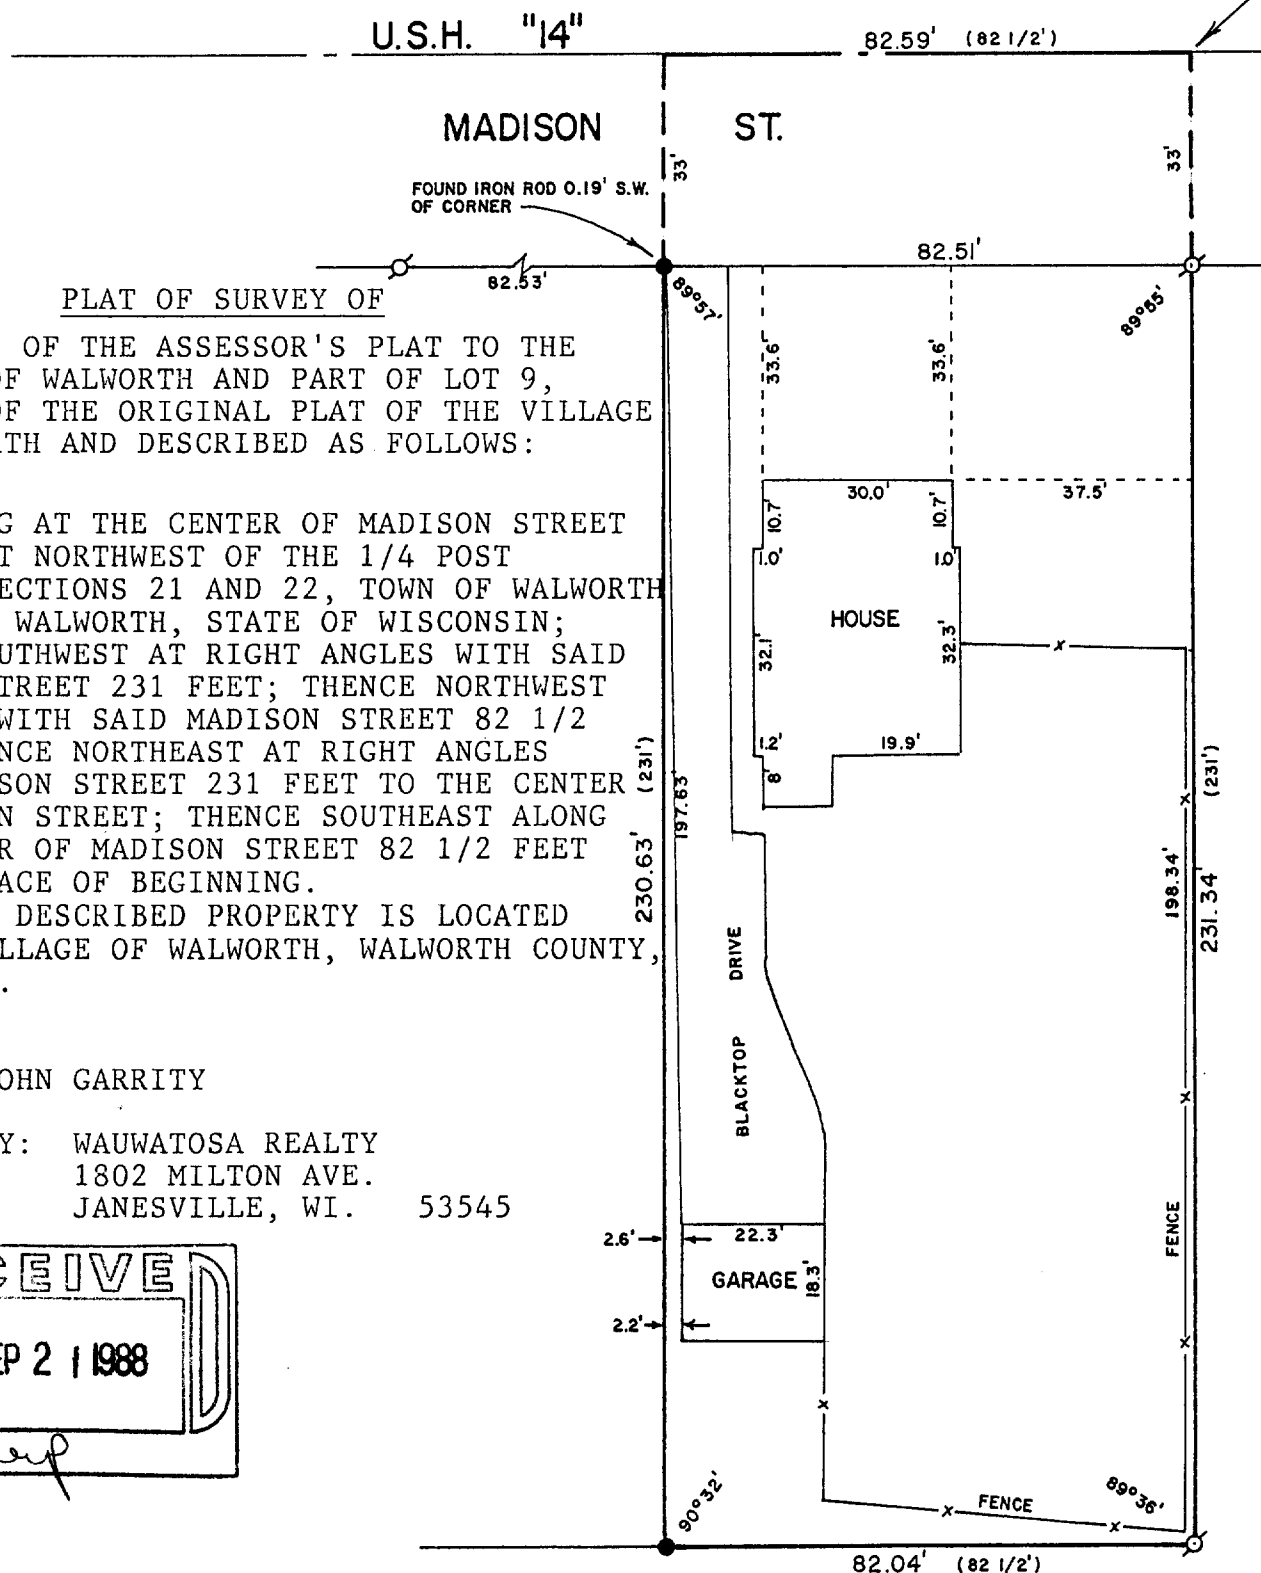


PLAT OF SURVEY OF

OUTLOT 33 OF THE ASSESSOR'S PLAT TO THE
 VILLAGE OF WALWORTH AND PART OF LOT 9,
 BLOCK 3 OF THE ORIGINAL PLAT OF THE VILLAGE
 OF WALWORTH AND DESCRIBED AS FOLLOWS:

COMMENCING AT THE CENTER OF MADISON STREET
 670.9 FEET NORTHWEST OF THE 1/4 POST
 BETWEEN SECTIONS 21 AND 22, TOWN OF WALWORTH
 COUNTY OF WALWORTH, STATE OF WISCONSIN;
 THENCE SOUTHWEST AT RIGHT ANGLES WITH SAID
 MADISON STREET 231 FEET; THENCE NORTHWEST
 PARALLEL WITH SAID MADISON STREET 82 1/2
 FEET; THENCE NORTHEAST AT RIGHT ANGLES
 WITH MADISON STREET 231 FEET TO THE CENTER
 OF MADISON STREET; THENCE SOUTHEAST ALONG
 THE CENTER OF MADISON STREET 82 1/2 FEET
 TO THE PLACE OF BEGINNING.
 THE ABOVE DESCRIBED PROPERTY IS LOCATED
 IN THE VILLAGE OF WALWORTH, WALWORTH COUNTY,
 WISCONSIN.

OWNER: JOHN GARRITY

ORDERED BY: WAUWATOSA REALTY
 1802 MILTON AVE.
 JANESVILLE, WI. 53545

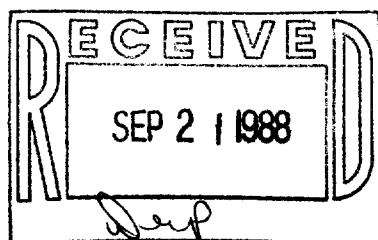

SCALE - 1"=30'

LEGEND

- ⊗ - IRON PIPE FOUND
- - IRON ROD FOUND
- () - RECORDED AS

I, DAVID F. ABELL, DO HEREBY CERTIFY
 THAT I HAVE SURVEYED THE PROPERTY
 HEREON DESCRIBED ACCORDING TO THE
 OFFICIAL RECORDS AND THAT THE PLAT
 HEREON IS A CORRECT REPRESENTATION
 OF THE PROPERTY LINES TO THE BEST OF
 MY KNOWLEDGE AND BELIEF.

David F. Abell

DAVID F. ABELL
 WISCONSIN REGISTERED LAND SURVEYOR, S-1596

June 22, 1988

DATE: JOB NUMBER -88118

NOTE: THIS IS NOT A CERTIFIED COPY UNLESS SEALED.