


DUNHAM SURVEYING, S.C.
SURVEYING & SUBDIVIDING
DELAVER, WISCONSIN 53115

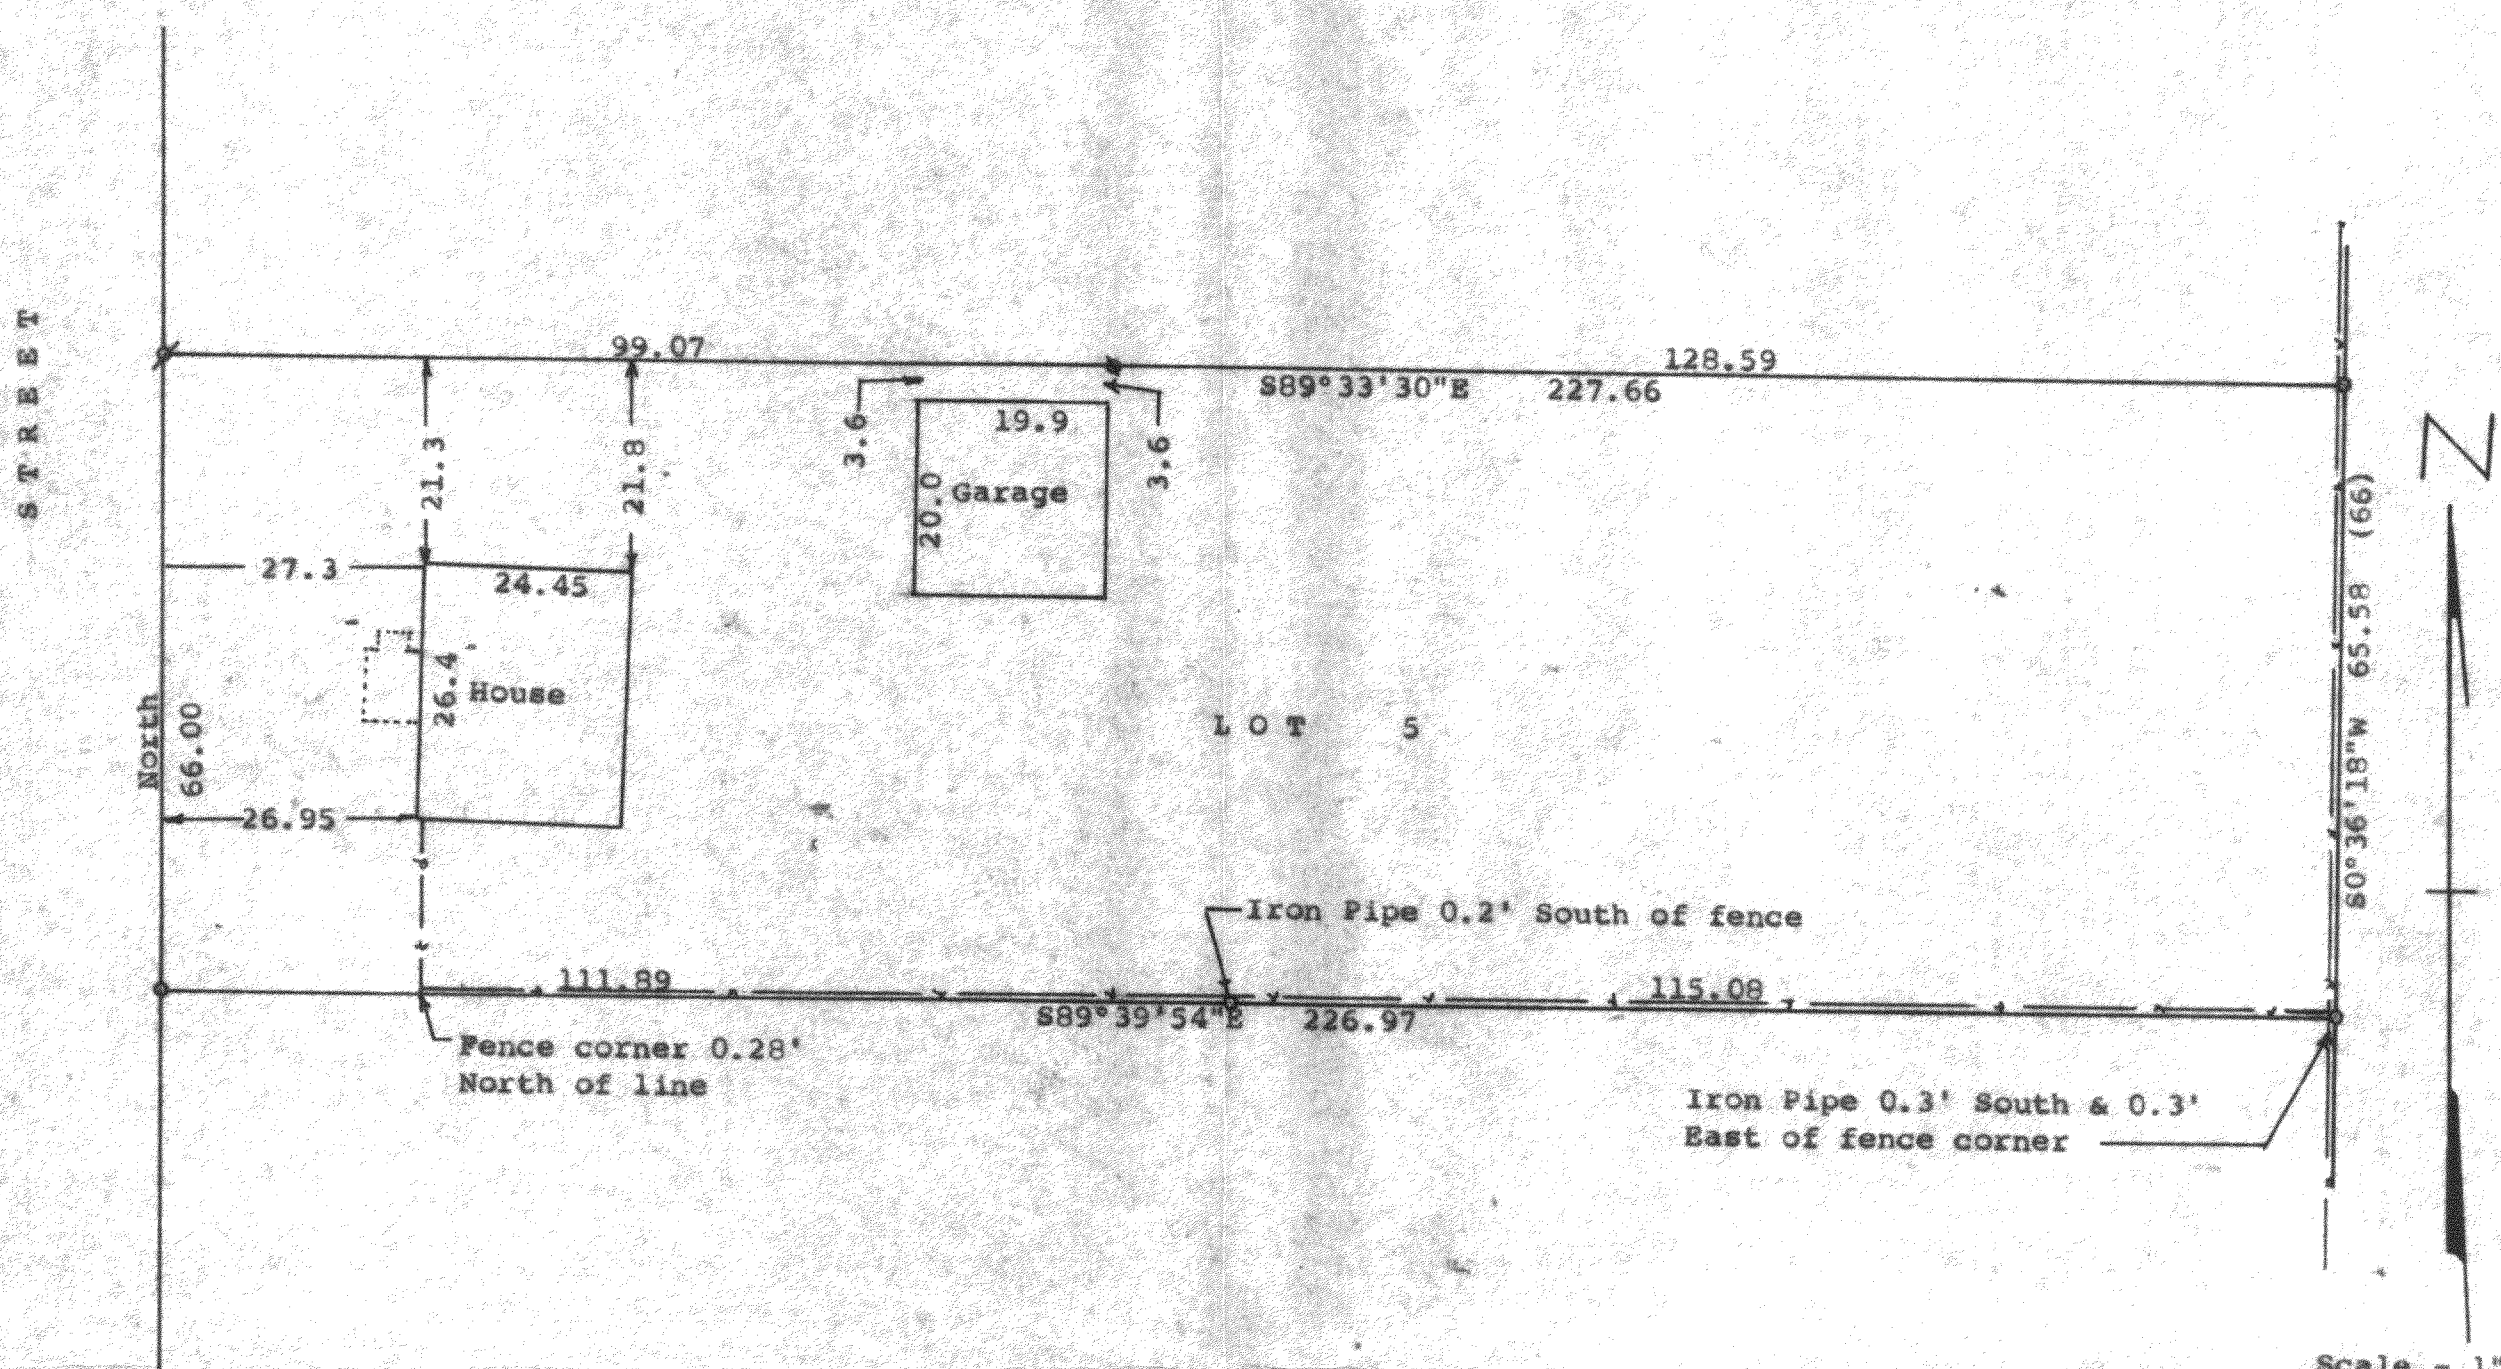

Scale - 1" = 20'
 s = 1" Iron Pipe Found
 o = 1 1/2" Iron Pipe Found
 a = 1 1/2" Iron Pipe Found
 (0.00) = recorded distance
 Bearings referenced to the east line
 of Weber Street with the assumed
 bearing of North
 Survey ordered by:
 Churchill Real Estate
 322 Park
 Walworth, WI 53184
 --- fence line

STATE OF WISCONSIN)
 COUNTY OF WALWORTH)

I, George T. Dunham, Surveyor, certify that I have surveyed the
 property described as follows:

Lot 5 in Block 1 of Crandall and Swinney's Subdivision, located
 in the Village of Walworth, Walworth County, Wisconsin,
 and that the plat shown hereon is a correct representation thereof and shows
 the size and location of the property, its exterior boundaries, the location
 of all visible structures and dimensions of all principal buildings thereon,
 boundary fences, apparent easements, roadways and visible encroachments, if
 any, and that I have surveyed the property hereon described, according to the
 official records, to the best of my knowledge and belief.
 October 19, 1990

George T. Dunham
 George T. Dunham, Surveyor

