

STREET

WEBER

49.5'

BLOCK

LOT 7

ABELL
SURVEYING & MAPPING

DELAVAN, WISCONSIN 53115

414-728-6737

227.06' (227.1')

FENCE 0.2' SOUTH OF LINE

FENCE 4.1' SOUTH OF LINE

FENCE 1.1' WEST OF LINE

IRON PIPE FOUND 0.92' EAST OF CORNER ON LINE EXTENDED

FENCE 0.5' EAST OF LINE

LOT 6

GARAGE

CONCRETE PATIO

SHED

SHED

HOUSE

CS

SW

GRAVEL

DRIVE

65.98' (66')

IRON PIPE FOUND 0.20' EAST OF CORNER

LOT 5

PLAT OF SURVEY OF

LOT 6, BLOCK 1, CRANDALL & SWINNEYS ADDITION TO THE
VILLAGE OF WALWORTH, WALWORTH COUNTY, WISCONSIN.




SCALE 1"=20'

LEGEND

- - IRON PIPE FOUND
- - IRON PIPE SET
- * - CHAINLINK FENCE
- SW - SIDEWALK
- CS - CONCRETE STOOP
- () - RECORDED AS

ORDERED BY: BRENNAN, STEIL LAW FIRM
P.O. BOX 446
DELAVAN, WI. 53115

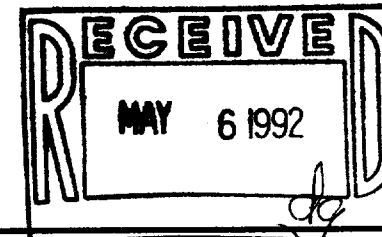

I HEREBY CERTIFY THAT I HAVE SURVEYED THE ABOVE DESCRIBED PROPERTY AND THAT THE ABOVE MAP IS A TRUE REPRESENTATION THEREOF AND SHOWS THE SIZE AND LOCATION OF THE PROPERTY, ITS EXTERIOR BOUNDARIES, THE LOCATION OF ALL VISIBLE STRUCTURES AND DIMENSIONS OF ALL PRINCIPAL BUILDINGS THEREON, BOUNDARY FENCES, APPARENT EASEMENTS, ROADWAYS AND VISIBLE ENCROACHMENTS, IF ANY, TO THE BEST OF MY KNOWLEDGE AND BELIEF.

THIS SURVEY IS MADE FOR THE USE OF THE PRESENT OWNERS OF THE PROPERTY, AND ALSO THOSE WHO PURCHASE, MORTGAGE, OR GUARANTEE THE TITLE THERETO WITHIN ONE (1) YEAR FROM DATE HEREOF.

David F. Abell

DAVID F. ABELL
WISCONSIN REGISTERED LAND SURVEYOR, S-1596

November 11, 1991

DATE JOB NUMBER - 91238

NOTE: THIS IS NOT A CERTIFIED COPY UNLESS SEALED.

009-441

VCS-6