


PLAT OF SURVEY

OF

PART OF OUTLOT 198 AND A 12 FOOT WIDE ALLEY
LOCATED IN THE SW $\frac{1}{4}$ OF SECTION 22, T1N R1E,
VILLAGE OF WALKWORTH, WALKWORTH COUNTY,
WISCONSIN.

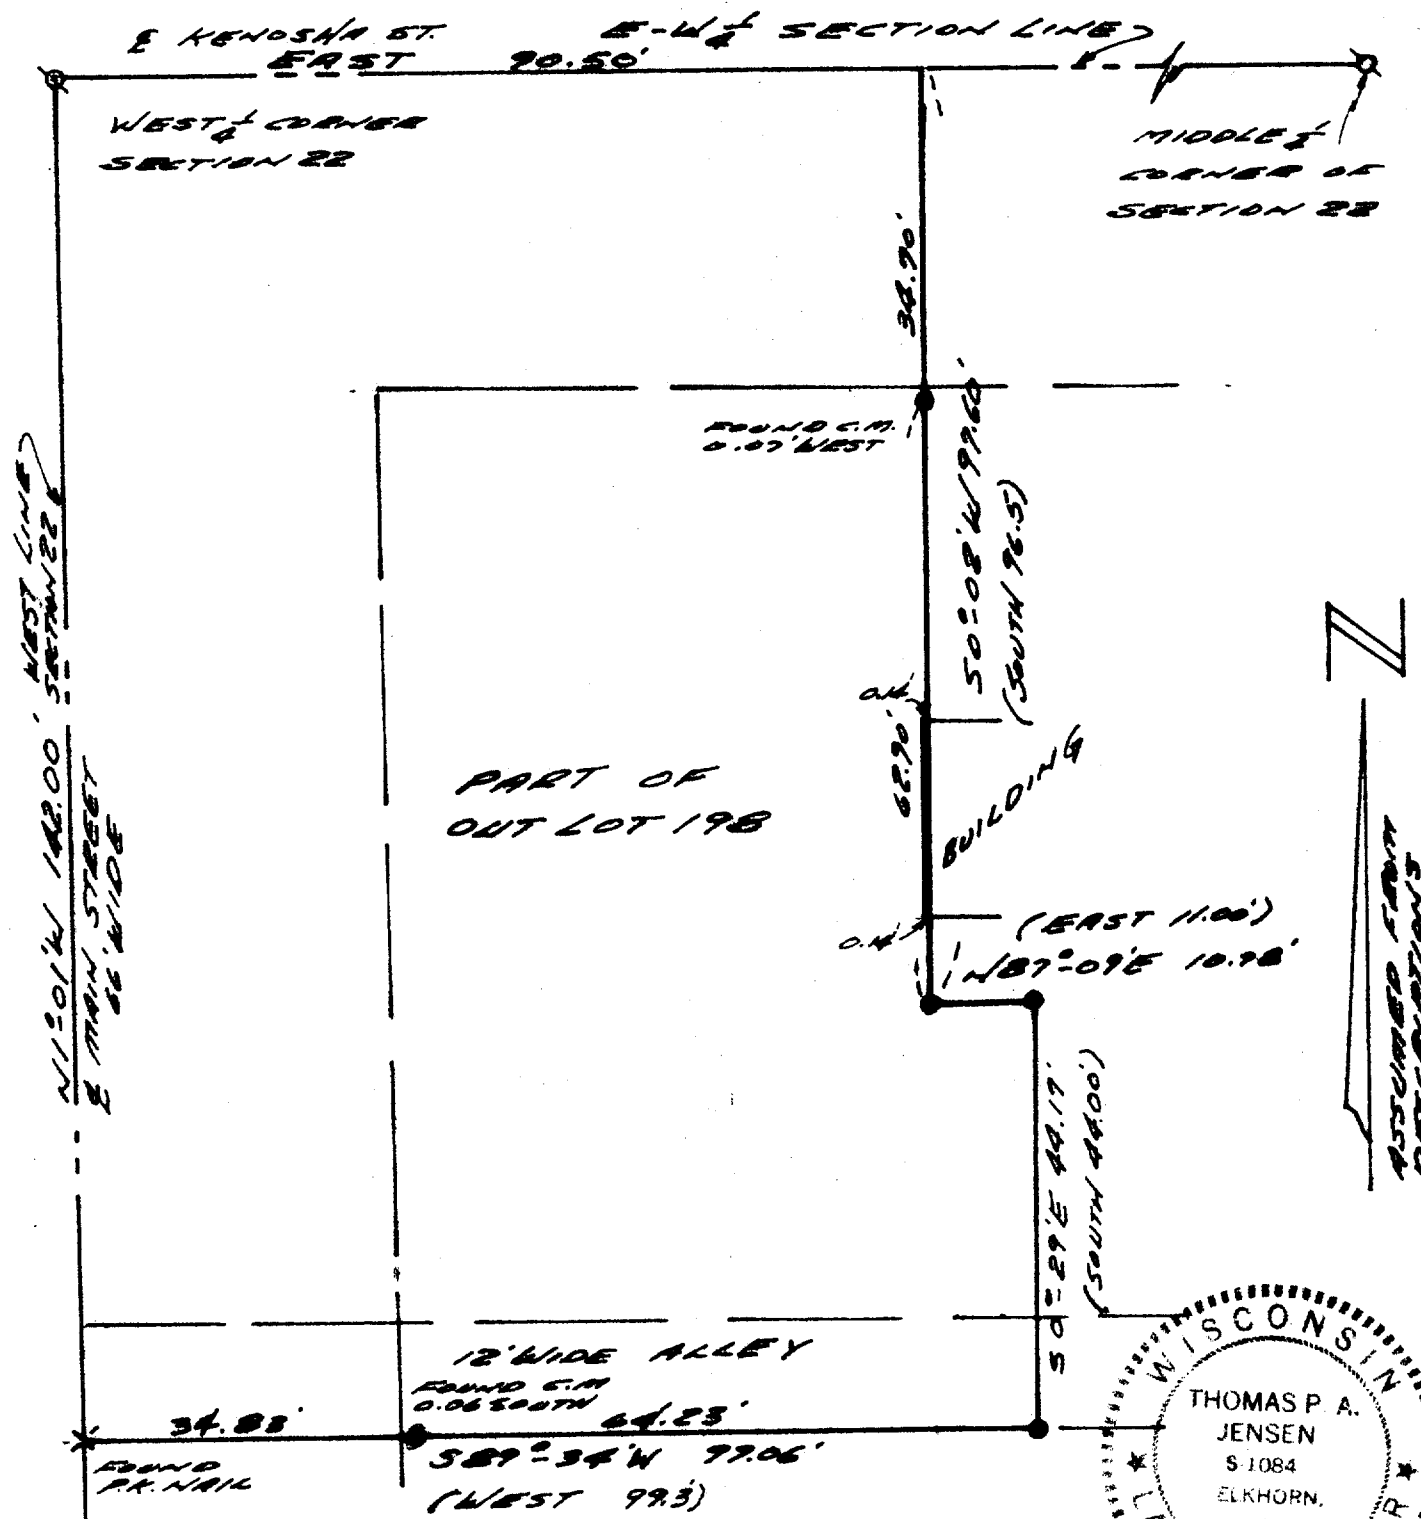

Parcel VW P-258

SURVEY AND PLAT BY
JENSEN & JOHNSON, INC.
CIVIL ENGINEERS AND SURVEYORS

Elkhorn, Wisconsin

LEGEND

- — Iron Pipe
- — Concrete Monument FOUND
- Scale 1" = 20'
- ⊕ — IRON PLUG FOUND

WE CERTIFY: That we have surveyed the above described property and that the plat shown hereon is an accurate survey and a true representation thereof and correctly shows the exterior boundary lines and all divisions of said property.

Date JAN. 4, 1973

Thomas P. A. Jensen
THOMAS P. A. JENSEN

Wisconsin Registered Land Surveyor, No. 5-1084

9-47