
## ABELL SURVEYING & MAPPING DELAVAN, WISCONSIN 53115 414-728-6787

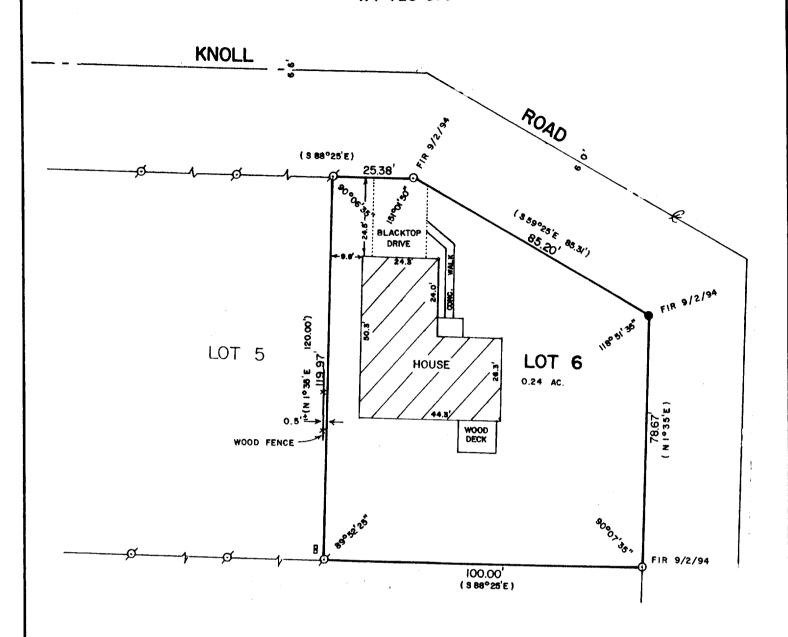

## PLAT OF SURVEY OF


LOT 6 OF THE MEADOWS OF WALWORTH, LOCATED IN THE VILLAGE OF WALWORTH, WALWORTH COUNTY, WISCONSIN.

ORDERED BY:

THE RAULAND AGENCY 118 KENOSHA STREET WALWORTH, WI. 53184

REVISED: SEPT. 21, 1994 ORDERED BY: KEEFE REAL ESTATE

> P.O. BOX 460 LAKE GENEVA, WI 53147

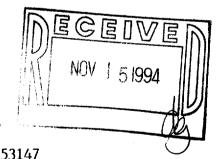



SCALE - 1"=30'

LEGEND - IRON PIPE FOUND

• - 2" IRON PIPE FOUND

LEANING, SET IRON ROD

O - SET IRON ROD ()- RECORDED AS I HEREBY CERTIFY THAT I HAVE SURVEYED THE ABOVE DESCRIBED PROPERTY AND THAT THE ABOVE MAP IS A TRUE REPRESENTATION THEREOF AND SHOWS THE SIZE AND LOCATION OF THE PROPERTY, ITS EXTERIOR BOUNDARIES, THE LOCATION OF ALL VISIBLE STRUCTURES AND DIMENSIONS OF ALL PRINCIPAL BUILDINGS THEREON, BOUNDARY FENCES, APPARENT EASEMENTS, ROADWAYS AND VISIBLE ENCROACHMENTS, IF ANY, TO THE BEST OF MY KNOWLEDGE AND BELIEF.

THIS SURVEY IS MADE FOR THE USE OF THE PRESENT OWNERS OF THE PROPERTY, AND ALSO THOSE WHO PURCHASE, MORTGAGE, OR GUARANTEE THE TITLE THERETO WITHIN ONE (1) YEAR FROM DATE HEREOF.

David 7. alel

DAVID F. ABELL HISCONSIN REGISTERED LAND SURVEYOR, S-1596

March 5 1990 REVISED: SEPT. 21, 1994

OATE
THIS IS NOT A CERTIFIED COPY UNLESS SEALED.

J-WWV