


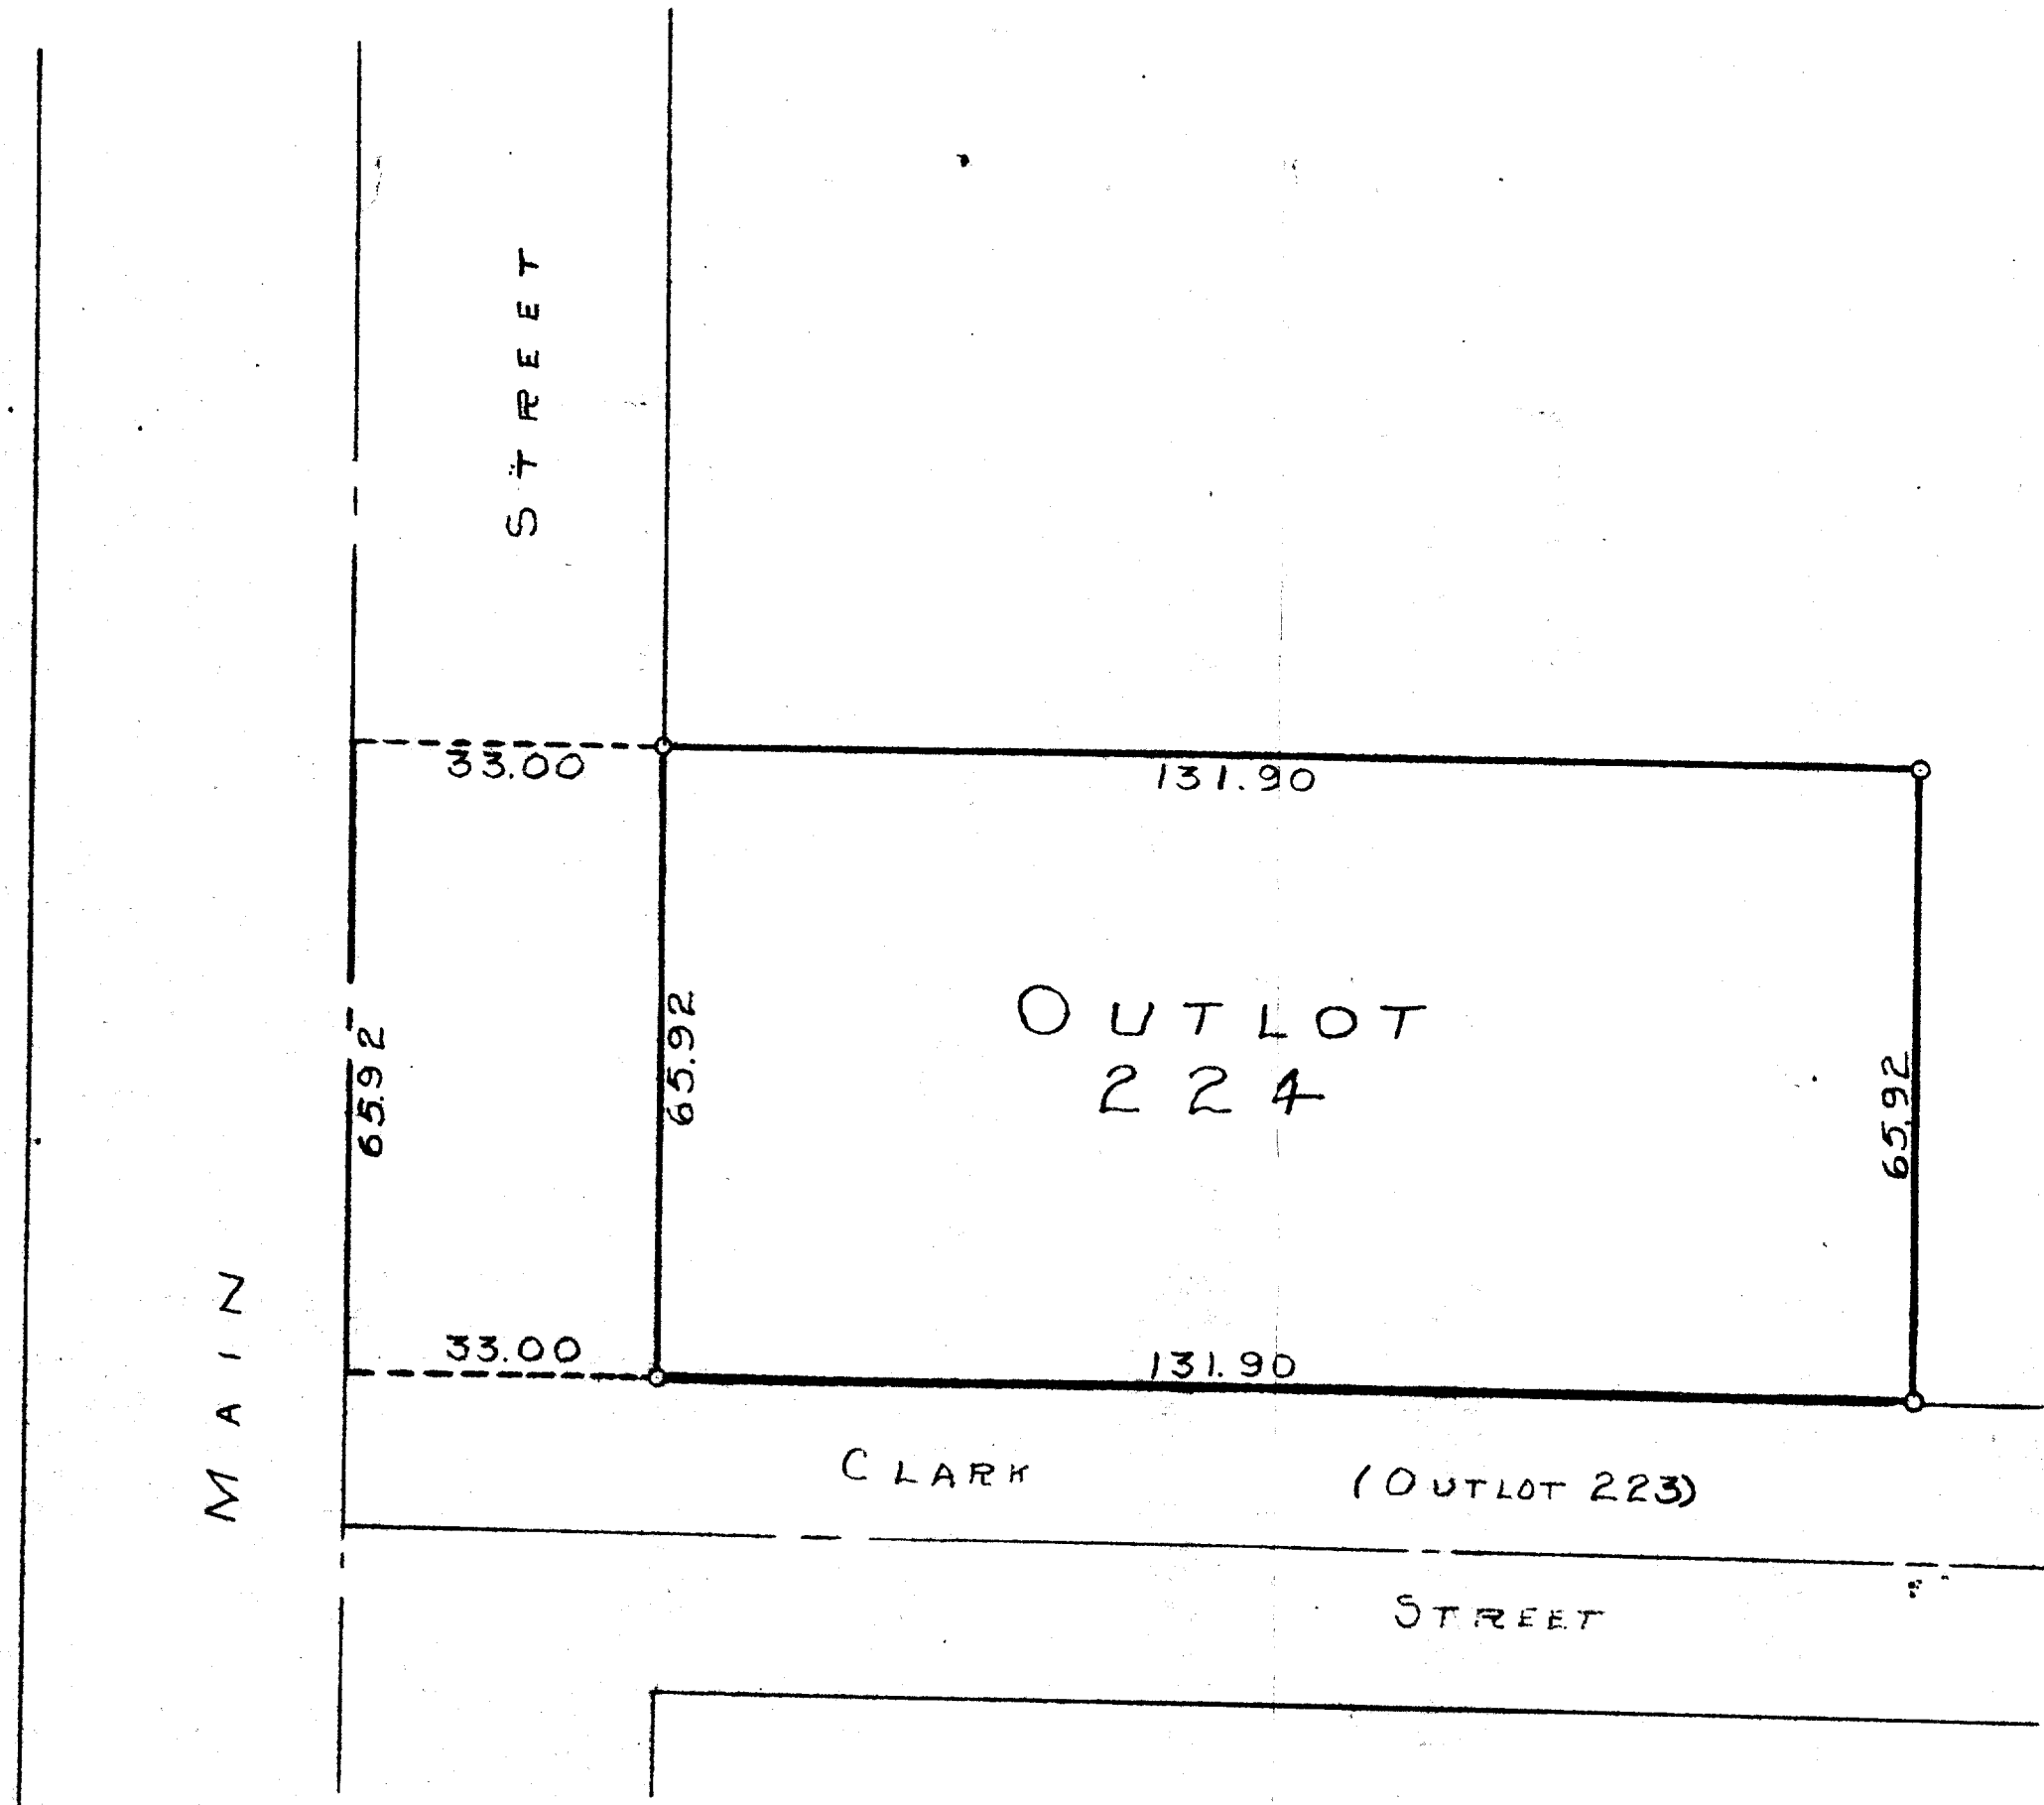

SCALE - 1" = 20'
O = IRON PIPE

PLAT OF SURVEY OF OUTLOT 224 OF THE ASSESSORS PLAT OF
THE VILLAGE OF WALWORTH, WALWORTH COUNTY, WISCONSIN.

JULY 8 1953

George T. Dunham
GEORGE T. DUNHAM
DELAVER, WISCONSIN
SURVEYOR