


DUNHAM SURVEYING, S.C.
SURVEYING & SUBDIVIDING
DELAVER, WISCONSIN 53115

N

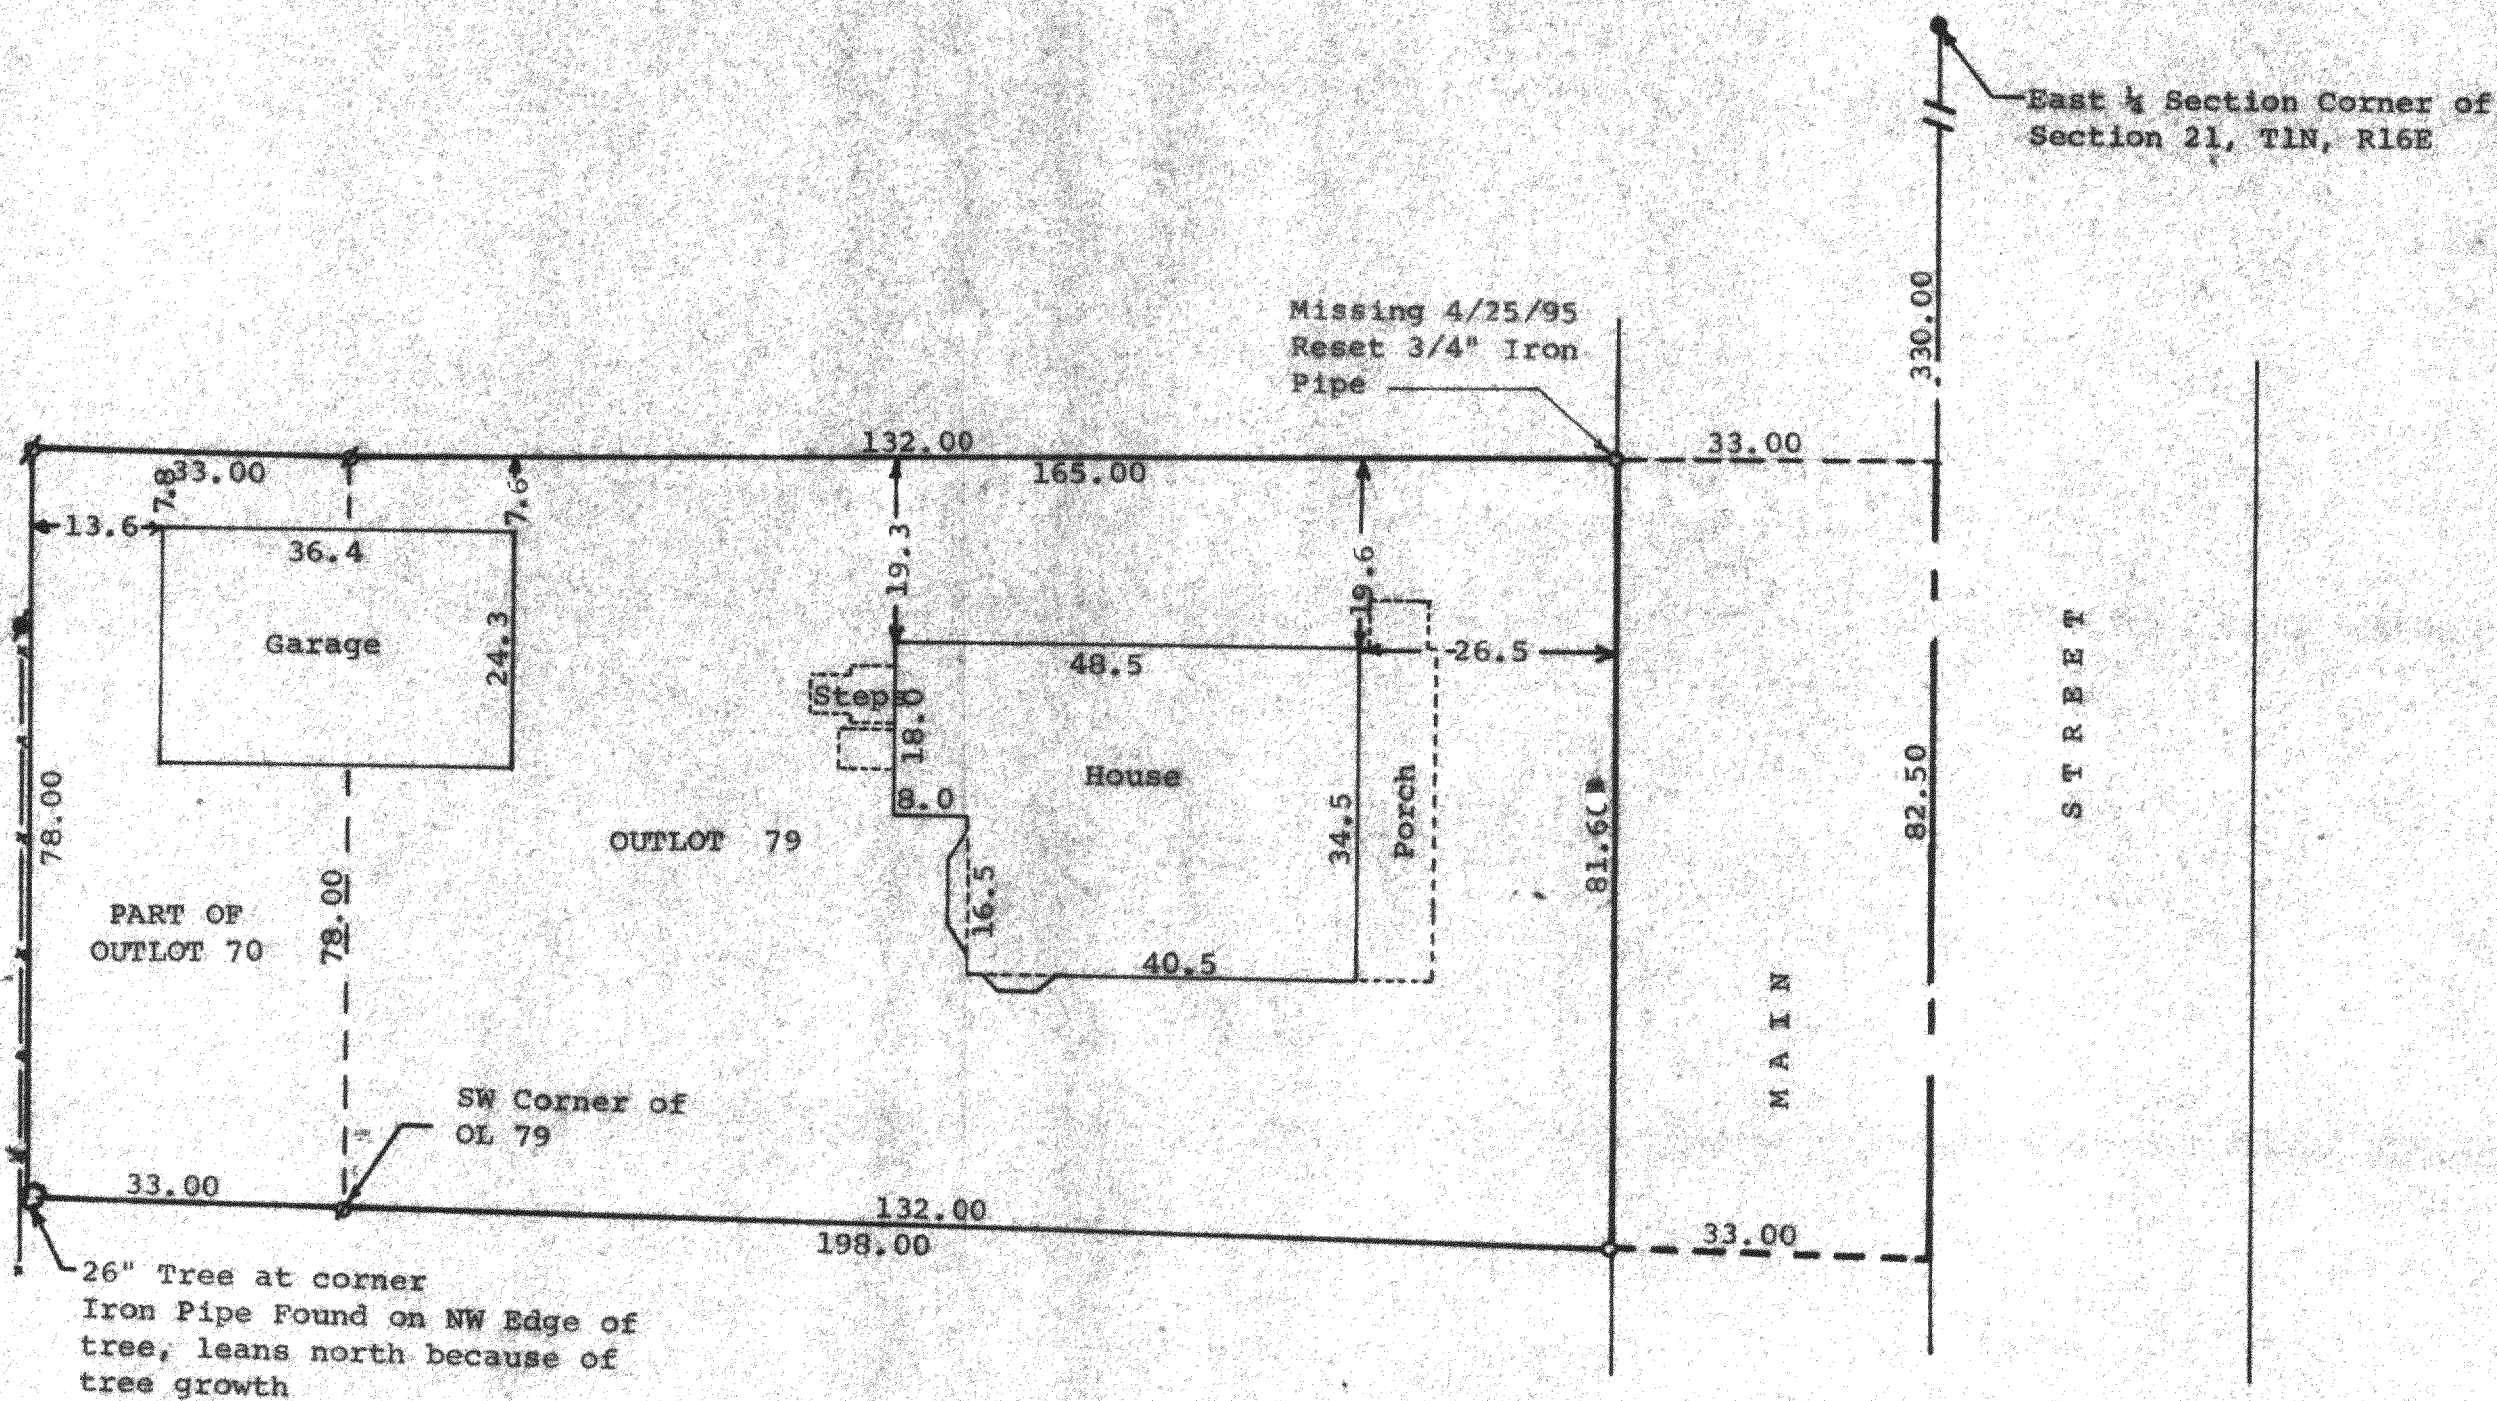

Scale - 1" = 20'

⊙ = Iron Pipe Found

○ = Iron Pipe Set

— = Fence Line

⊙ = Power Pole

● = Metal Plate

Updating and recertification ordered by:
The Rauland Agency
118 Kenosha
Walworth, WI 53184

STATE OF WISCONSIN) ss
COUNTY OF WALWORTH)

I, George T. Dunham, Surveyor, certify that I have surveyed the property described as follows:

Outlot 79, Assessors Plat, Village of Walworth, Walworth County, Wisconsin. Also a 33 foot parcel measured East and West located adjacent to and directly west of Outlot 79 in the Village of Walworth, being more particularly described as follows: Beginning at the southwest corner of said Outlot 79; thence westerly along the north line of Outlot 78, a distance of 33 feet; thence northerly parallel to the west line of South Main Street 78 feet; thence easterly in a line parallel to the south line of Outlot 79, a distance of 33 feet to the northwest corner of Outlot 79; thence southerly along the westerly line of Outlot 79, 78 feet to the place of beginning.



and that the above map is a true representation thereof and shows the size and location of the property, its exterior boundaries, the location of all visible structures and dimensions of all principal buildings thereon, boundary fences, apparent easements, roadways and visible encroachments, if any.

This survey is made for the use of the present owners of the property, and also those who purchase, mortgage, or guarantee the title thereto within one (1) year from date hereof.

January 25, 1979

Updated and recertified to this
25th day of April, 1995

George T. Dunham
George T. Dunham, Surveyor

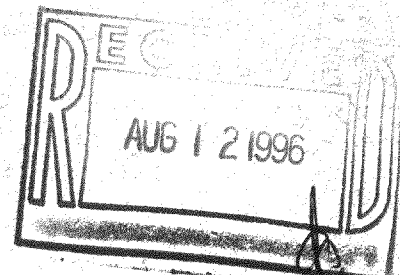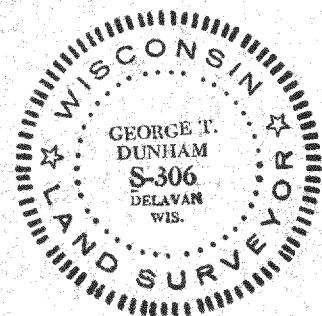

VWP-91
889-561