


DUNHAM SURVEYING, S.C.
SURVEYING & SUBDIVIDING
DELAVER, WISCONSIN 53115

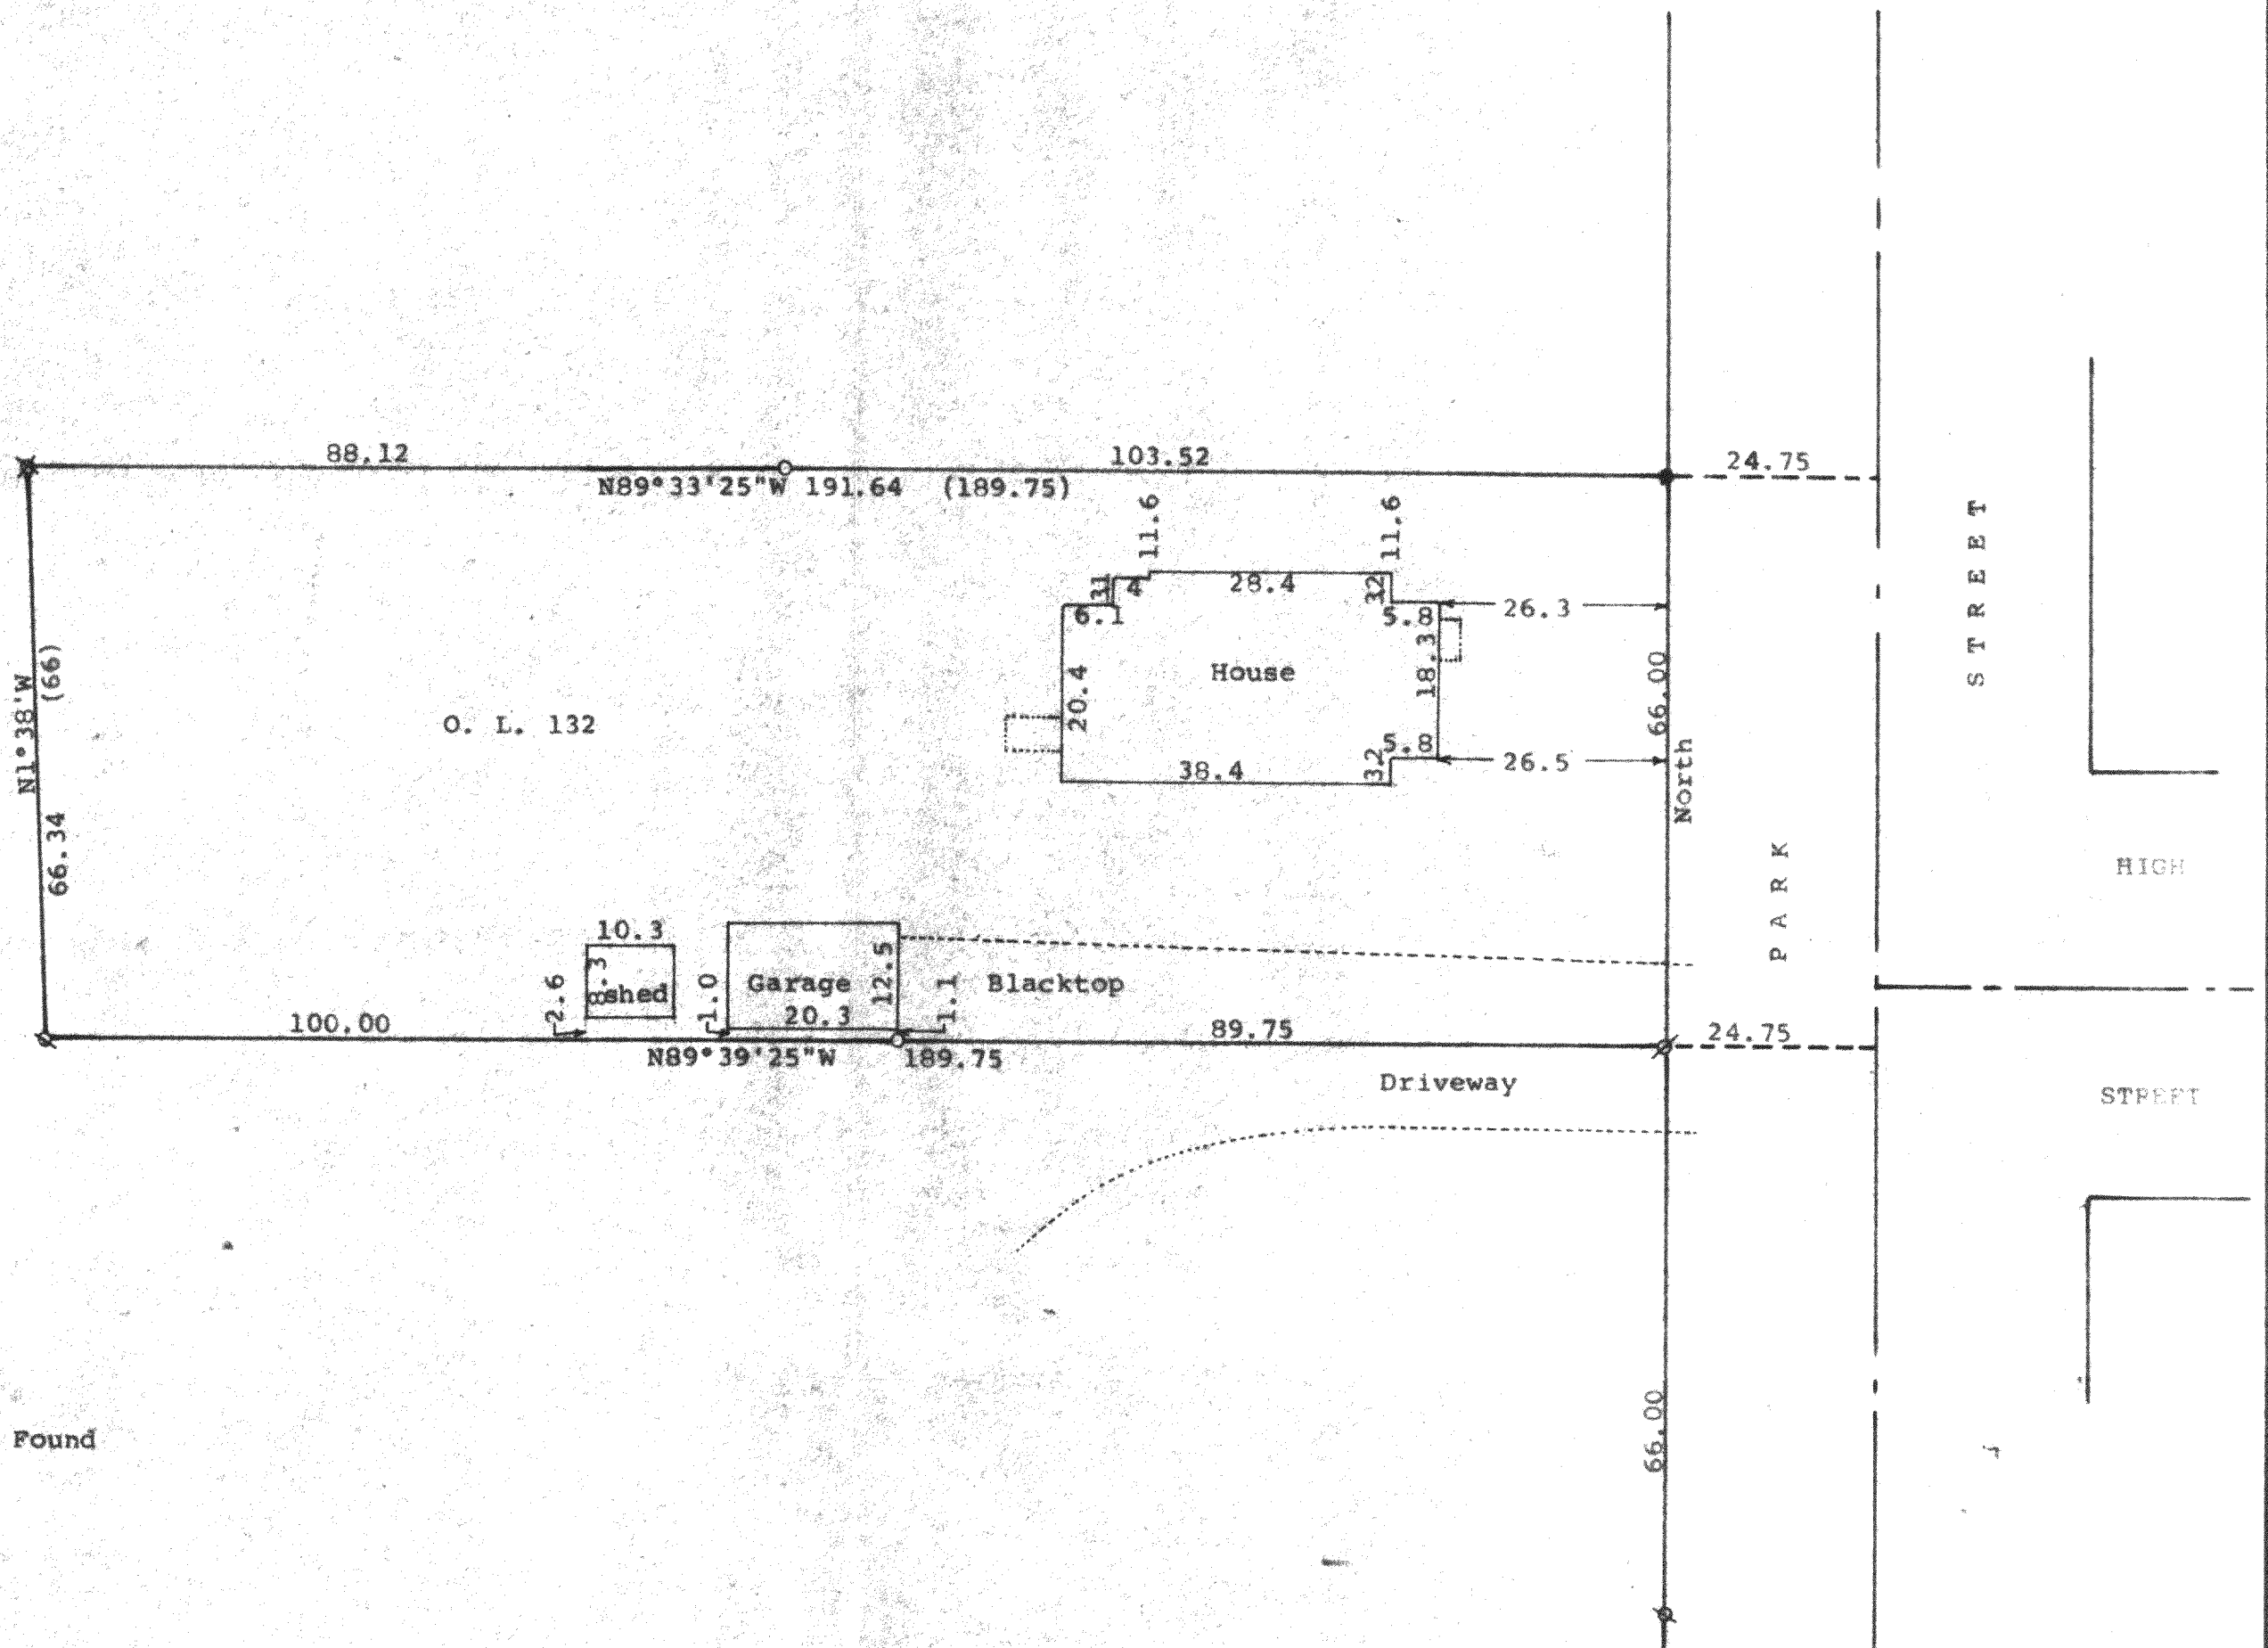

Scale - 1" = 20'
 Ø = crooked 1/2" Iron Pipe Found
 reset 3/4" Iron Pipe
 O = 1/2" Iron Pipe Set
 Q = 1" Iron Pipe Found
 ● = 1 1/4" Iron Pipe Found
 X = 1/2" Iron Pipe Found
 (0.00) = recorded distance
 Bearings referenced to the west line of
 Park Street. Assumed bearing North
 Survey ordered by:
 Churchill Real Estate
 P.O. Box 577
 Walworth, WI 53184



STATE OF WISCONSIN)
 COUNTY OF WALWORTH) SS

I, George T. Dunham, Surveyor, certify that I have surveyed the
 property described as follows:

Outlot No. 132 of the Assessors Plat of the Village of Walworth,
 Walworth County, Wisconsin,

and that the plat shown hereon is a correct representation thereof and shows
 the size and location of the property, its exterior boundaries, the location
 of all visible structures and dimensions of all principal buildings thereon,
 boundary fences, apparent easements, roadways and visible encroachments, if
 any, and that I have surveyed the property hereon described, according to the
 official records, to the best of my knowledge and belief.
 June 7, 1996

George T. Dunham
 George T. Dunham, Surveyor

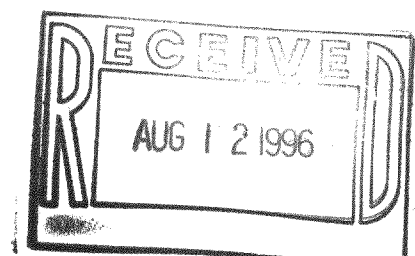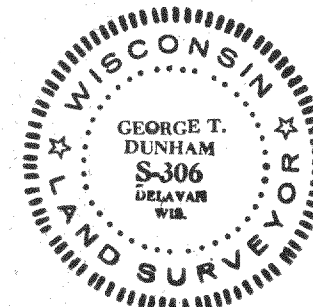

WWP-154
 009-566