


AMERICAN SURVEYING COMPANY, INC.

12207 C.T.H. "K" FRANKSVILLE, WISCONSIN 53126 TEL. (414) 835-4774 FAX: (414) 835-2379

PLAT OF SURVEY

PREPARED FOR: OAK KNOLLS, LLC DESCRIPTION:

Lot 59 of "OAK KNOLLS OF WALWORTH, ADDITION NO. 1"A, Being a resubdivision of Outlot No. 1 of "OAK KNOLLS OF WALWORTH" being a subdivision of the Southeast 1/4 of Section 22, Town 1 North, Range 16 East, in the Village of Walworth, County of Walworth, State of Wisconsin.

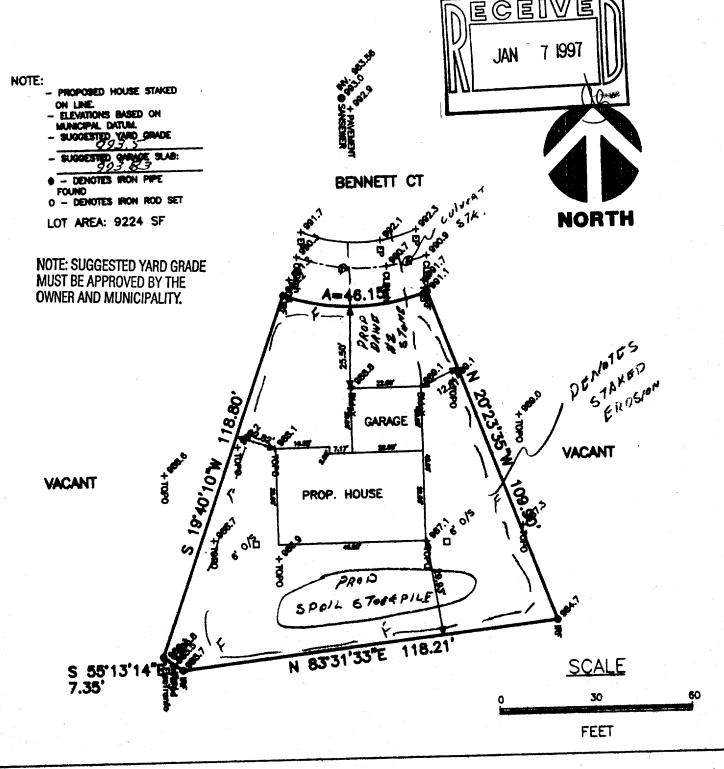

STATE OF WISCONSIN COUNTY OF RACINE

The above described property has been surveyed under my direction and the above map is a correct representation thereof

Dated at NORTH CAPE; this 15th day of AUGUST, 1996

Recertified xxxxxxxxxxxxxxxxxxxxxxxxxxx

Registered Land Surveyor

JOB NO. 96235 DRAWING NAME: 96235

JOB DRA PETE L.
BATLEY
S-1398
NORTH CAPE.
WI

NOK 7-35 008-280