

Plat of Topographic Survey For
"ONVOY" a Division of "BADGER PLUG"

In NE1/4 Section 21-1-16

VILLAGE OF WALWORTH
WALWORTH COUNTY, WIS.

ordered by
Hoffman Corporation
for
Badger Plug Company

Scale 1"=50'

SYMBOLS

LP light pole

spruce tree

box elder tree

ornamental tree

G G gas

W W water

indicates iron
boundary marker

Elevations hereon, shown thus ± 993.90 , refer to datum shown on sanitary sewer plans on file at the Village of Fontana and Village of Walworth, water pollution control plant. See Bench Marks shown.

Contour interval = 1'

The boundaries of this survey are based on a retracement of a 1972 survey by County Surveyor, Lloyd L. Jensen.

Bearings shown hereon, refer to those shown on prior surveys by Harold H. Kolb (S-187), in 1983, 1986 and 1991.

30' easement, invert elevations, gas and water locations taken from plans on file at Fontana - Walworth Water Pollution Control Facility - by Strana & Assoc. Consulting Engineers (dated June 1984 - constructed 1985)

MARISCALCO COUNTYWIDE SURVEYING, INC.
1120 80TH STREET KENOSHA, WI 53143
(414) 654 8808 FAX (414) 654 1120





I hereby certify that this property was surveyed under my direction and this plat is a true representation thereof.

Reg. Land Surveyor

April 1, 1998

A-1 Agricultural - Holding District

B-3 Highway Business District

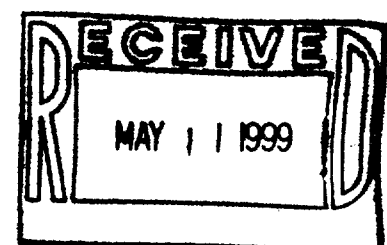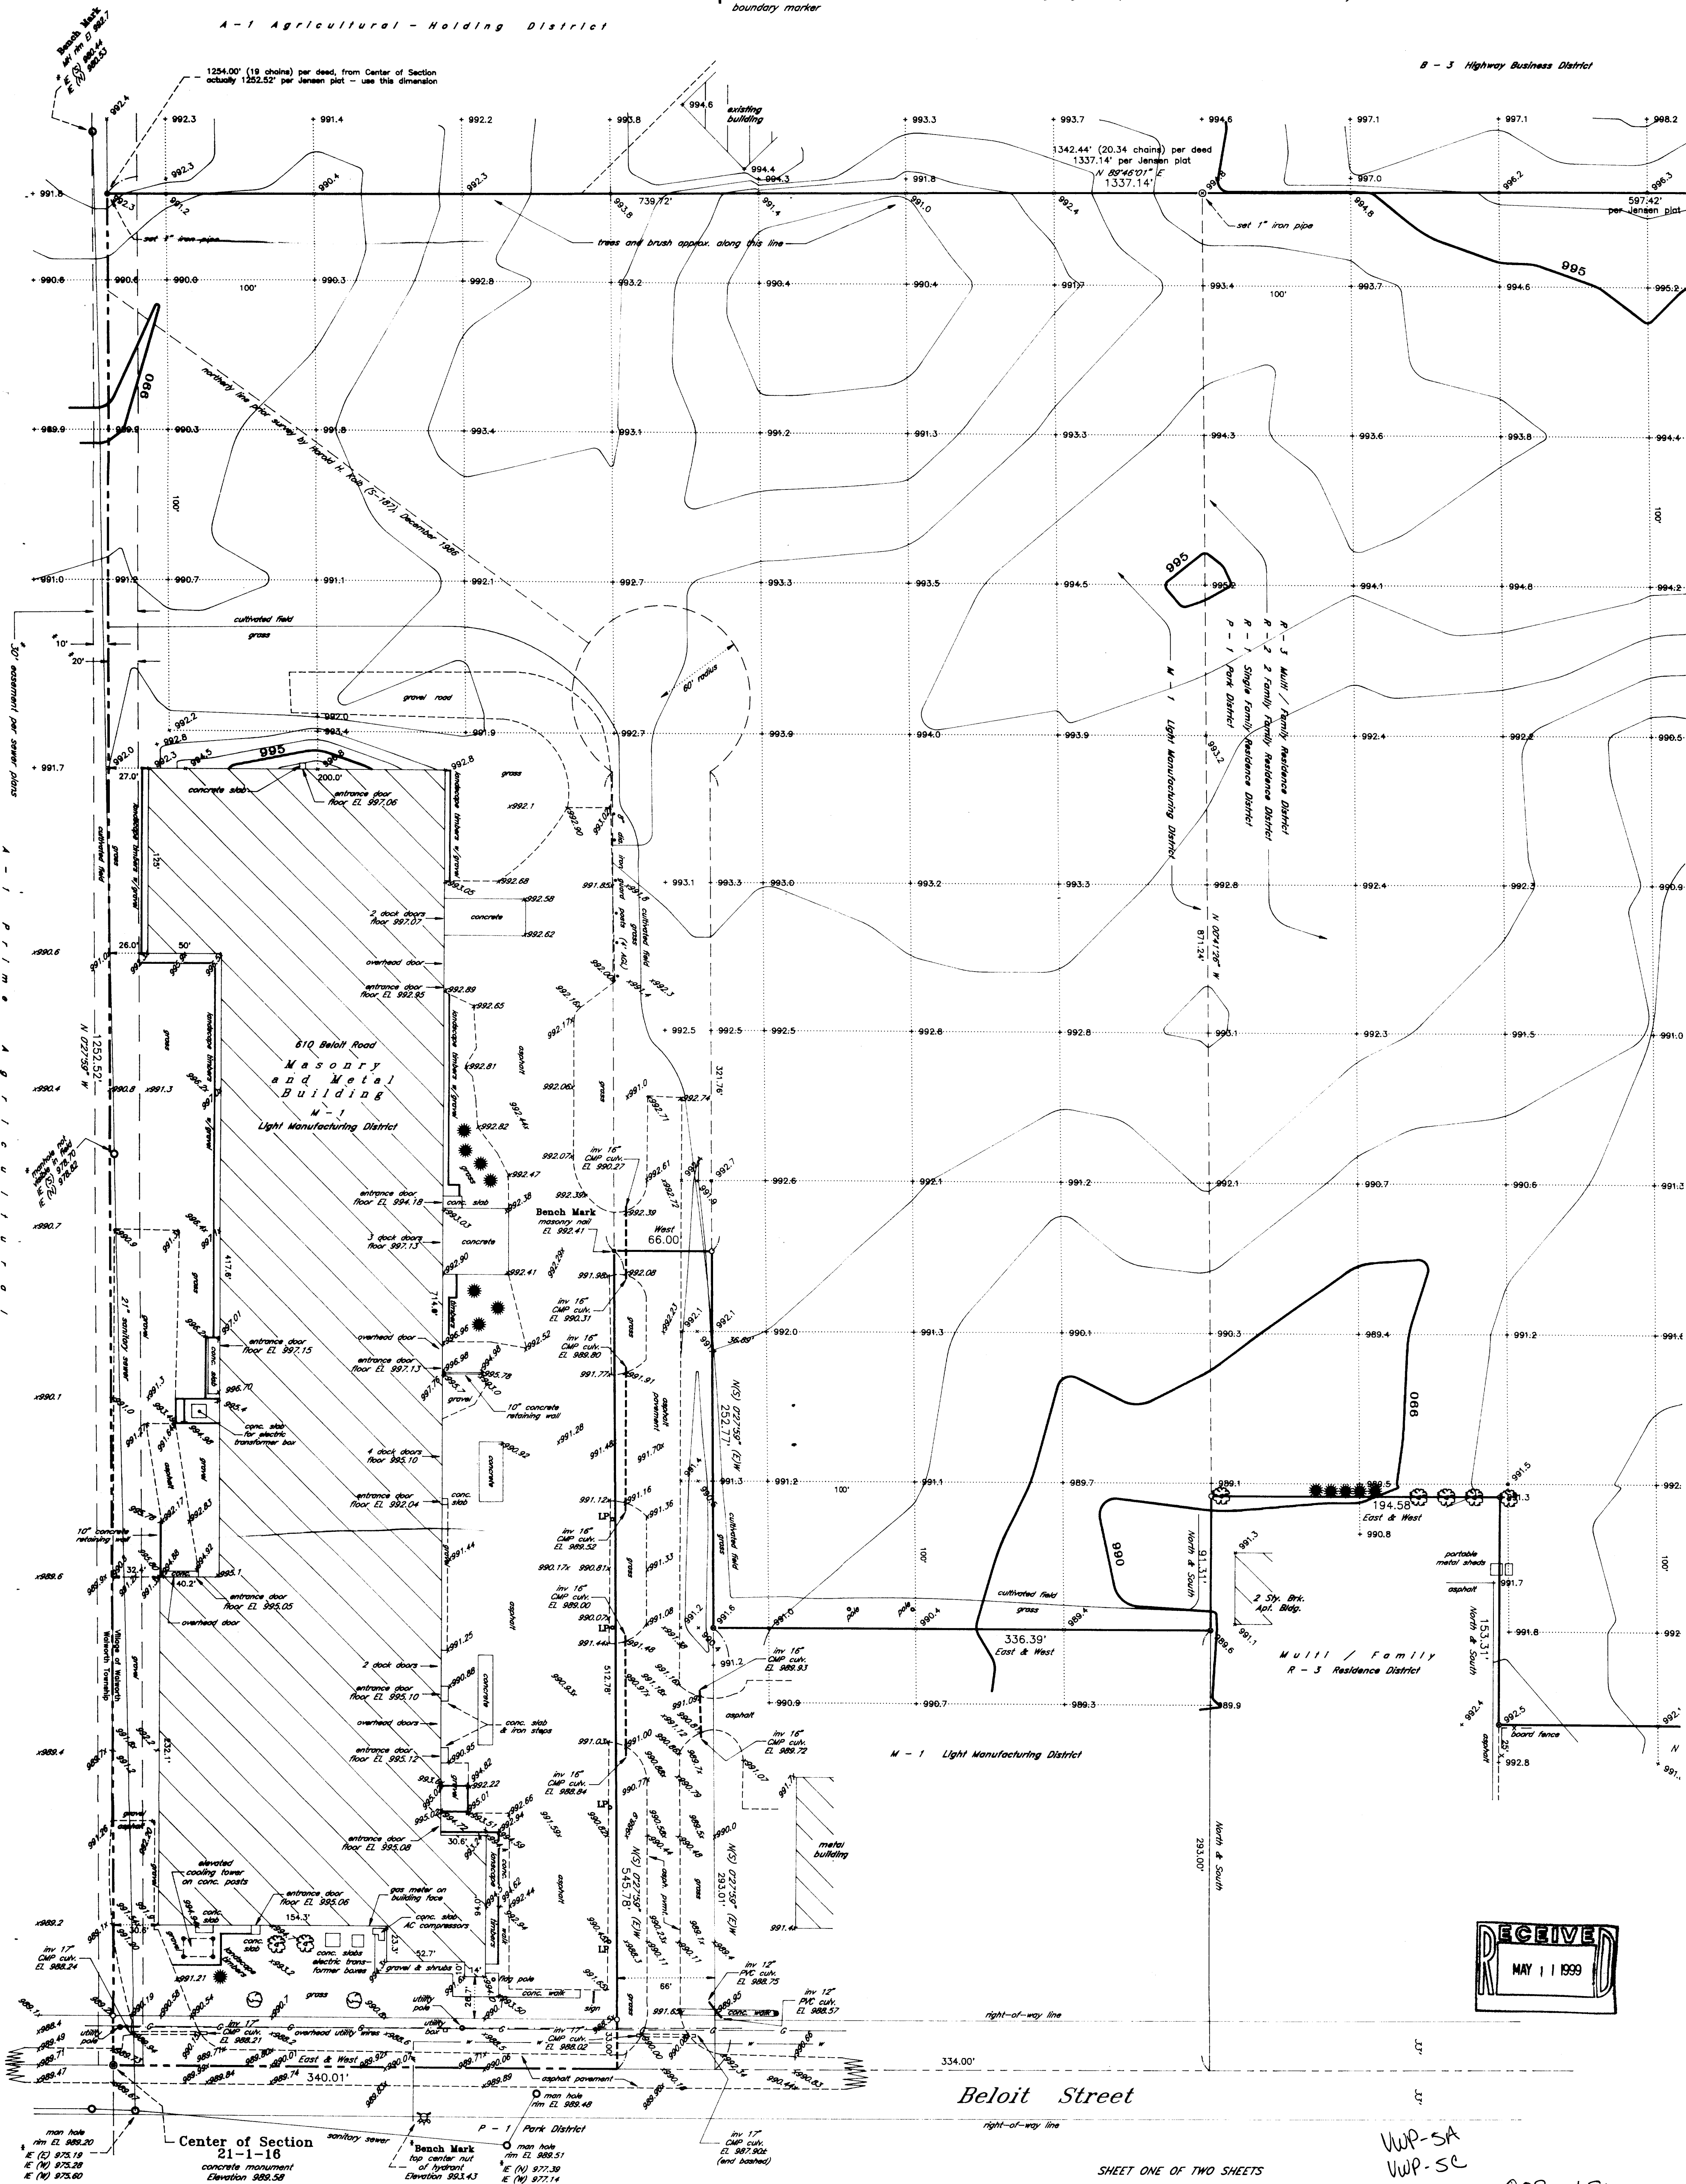

Beloit Street

SHEET ONE OF TWO SHEETS

WVP-SA
WVP-SC

009-686