


HAROLD H. KOLB
REGISTERED PROFESSIONAL LAND SURVEYOR
WISCONSIN

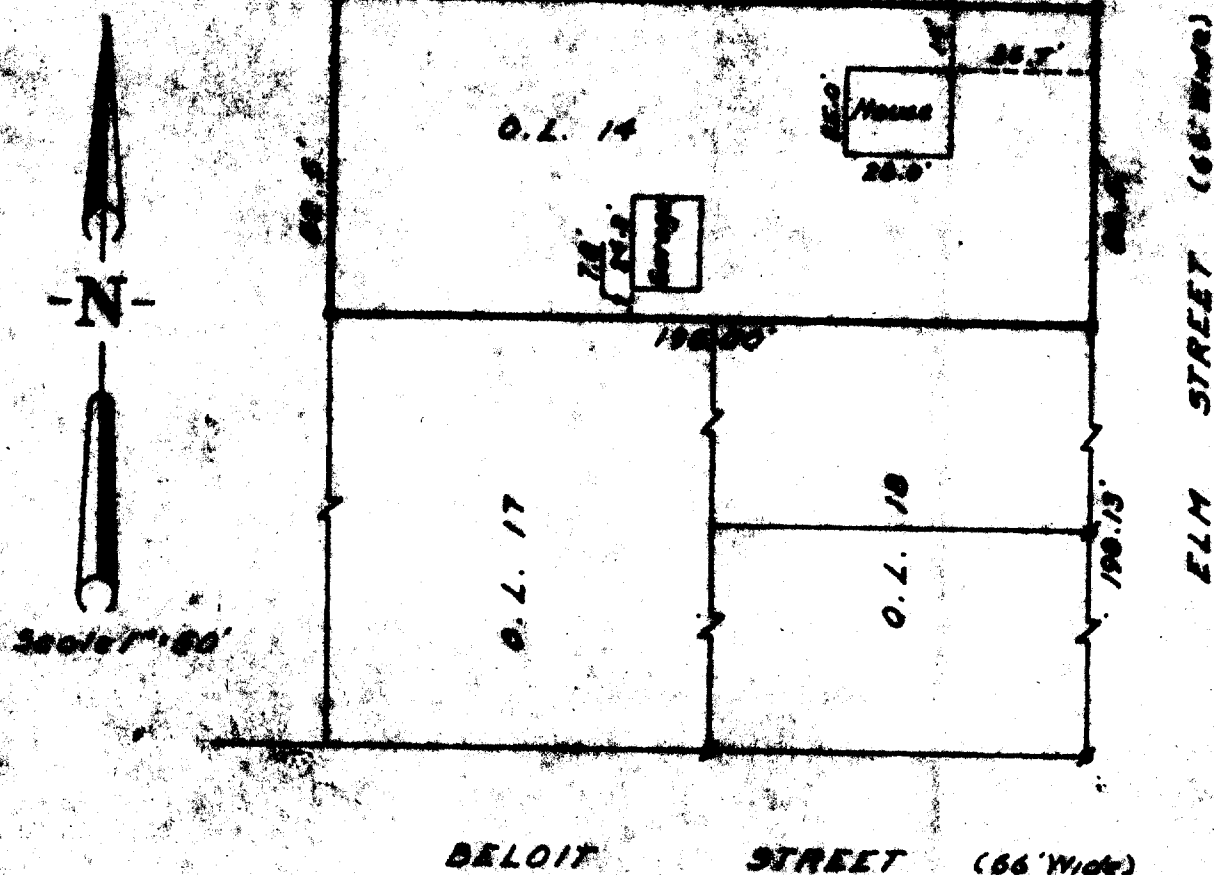

PART OF SURVEY OF

Outlet 14, of the Associates Plat, Village of
Wauwatosa, Wauwatosa County, Wisconsin.

LEGEND

- IRON PIPE FOUND
- — IRON PIPE PLACED
- — CONCRETE MONUMENT
- x — SPIKE

I, HAROLD H. KOLB, DO HEREBY CERTIFY THAT I HAVE
 SURVEYED THE PROPERTY HEREON DESCRIBED ACCORDING
 TO THE OFFICIAL RECORDS, AND THAT THE PLAT HEREON
 IS A CORRECT REPRESENTATION OF THE LOT LINES, AND
 THE PRINCIPAL LINES OF THE BUILDINGS

Harold H. Kolb

HAROLD H. KOLB

WISCONSIN REGISTERED LAND SURVEYOR, S-187

DATE February 10, 1964

REVISED March 10, 1964

VWP-23

9-88