


1140 SEQUOIA STREET • DELAVAN, WISCONSIN 53115  
262-728-6737

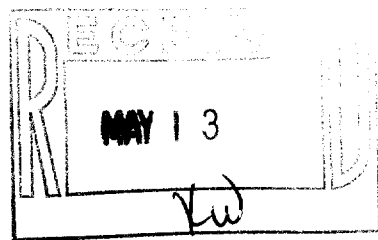

LOTS 1-3, BLOCK 7, EAST SIDE 2ND ADDITION,  
VILLAGE OF WALWORTH, WALWORTH COUNTY, WISCONSIN.

ORDERED BY: CENTURY 21-SKANDIA REALTY  
830 E. GENEVA STREET  
DELAVAN, WI 53115

NOTE: THE BEARING ON THE WEST LINE OF READ AVENUE IS ASSUMED NORTH-SOUTH.



SCALE 1" = 20'

### LEGEND

-  - IRON PIPE FOUND  
 - IRON ROD FOUND  
 - UTILITY POLE  
 CS - CONCRETE STOOP  
 ( ) - RECORDED AS

I HEREBY CERTIFY THAT I HAVE SURVEYED THE ABOVE DESCRIBED PROPERTY AND THAT THE ABOVE MAP IS A TRUE REPRESENTATION THEREOF AND SHOWS THE SIZE AND LOCATION OF THE PROPERTY, ITS EXTERIOR BOUNDARIES, THE LOCATION OF ALL VISIBLE STRUCTURES AND DIMENSIONS OF ALL PRINCIPAL BUILDINGS THEREON, BOUNDARY FENCES, APPARENT EASEMENTS, ROADWAYS AND VISIBLE ENCROACHMENTS, IF ANY, TO THE BEST OF MY KNOWLEDGE AND BELIEF.

THIS SURVEY IS MADE FOR THE USE OF THE PRESENT OWNERS OF THE PROPERTY, AND ALSO THOSE WHO PURCHASE, MORTGAGE, OR GUARANTEE THE TITLE THERETO WITHIN ONE (1) YEAR FROM DATE HEREON.

David F. Bell

DAVID F. ABELL  
WISCONSIN REGISTERED LAND SURVEYOR, S-1596

March 5, 2004

DATE \_\_\_\_\_ JOB NUMBER - 04011  
NOTE: THIS IS NOT A CERTIFIED COPY UNLESS SEALED.

VES2 00011

009-915