


DUNHAM SURVEYING, S.C.
SURVEYING & SUBDIVIDING
DELAVER, WISCONSIN 53115

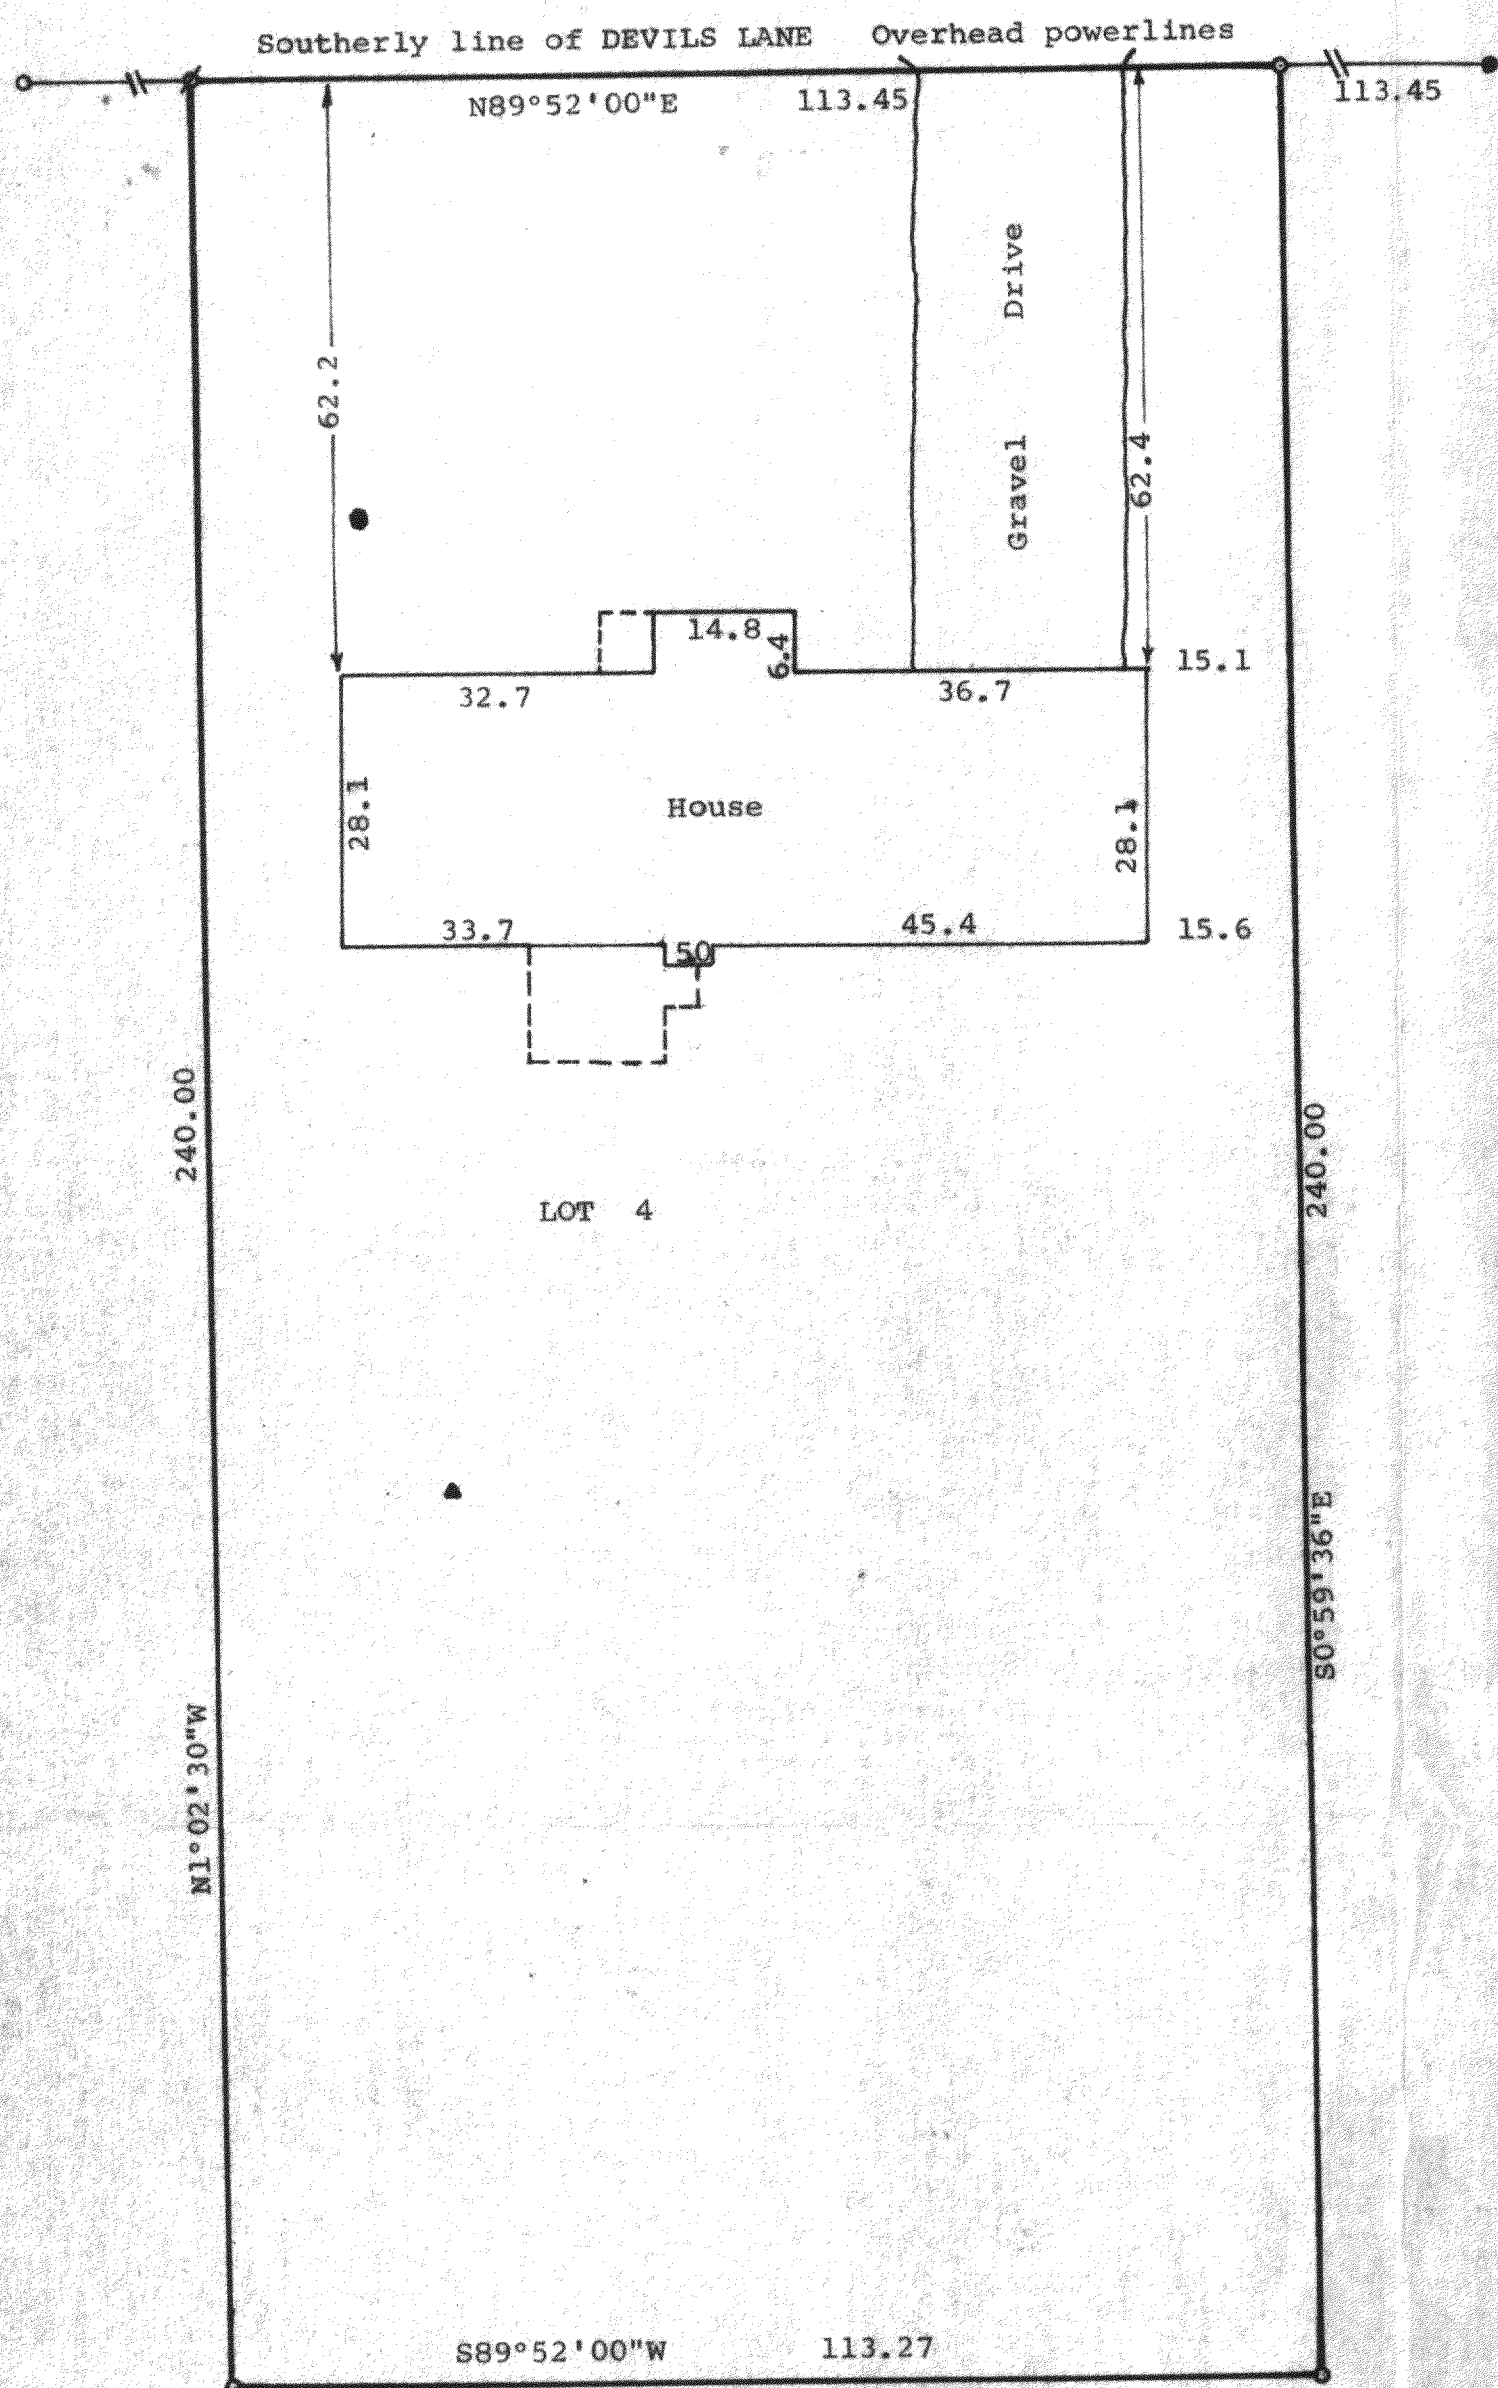


Scale - 1" = 20'
 ○ = 1" Dia. Iron Pipe Found
 ● = 2" Dia. Iron Pipe Found
 ● = Well
 ▲ = Vent
 ○ = 3/4" X 24" Iron Pipe Set
 Bearings are those of record.
 Owner: Michael Harper
 Devils Lane
 Walworth, Wis. 53184

STATE OF WISCONSIN) SS
 COUNTY OF WALWORTH)

I, George T. Dunham, Surveyor, certify that I have surveyed the property described as follows.

Lot 4 of Dean Subdivision, located in the Southeast 1/4 of Section 22, Village of Walworth, Walworth County, Wisconsin, and that the map shown above is a true representation thereof and shows the size and location of the property, its exterior boundaries, the location of all visible structures and dimensions of all principal buildings thereon, boundary fences, apparent easements, roadways and visible encroachments, if any, and that I have surveyed the property hereon described according to the official records, to the best of my knowledge and belief.
 November 17, 1983.

George T. Dunham
 George T. Dunham, Surveyor

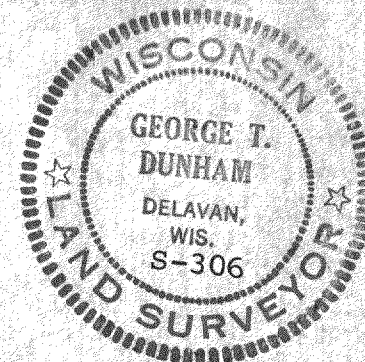

VCD 00004

9-229