
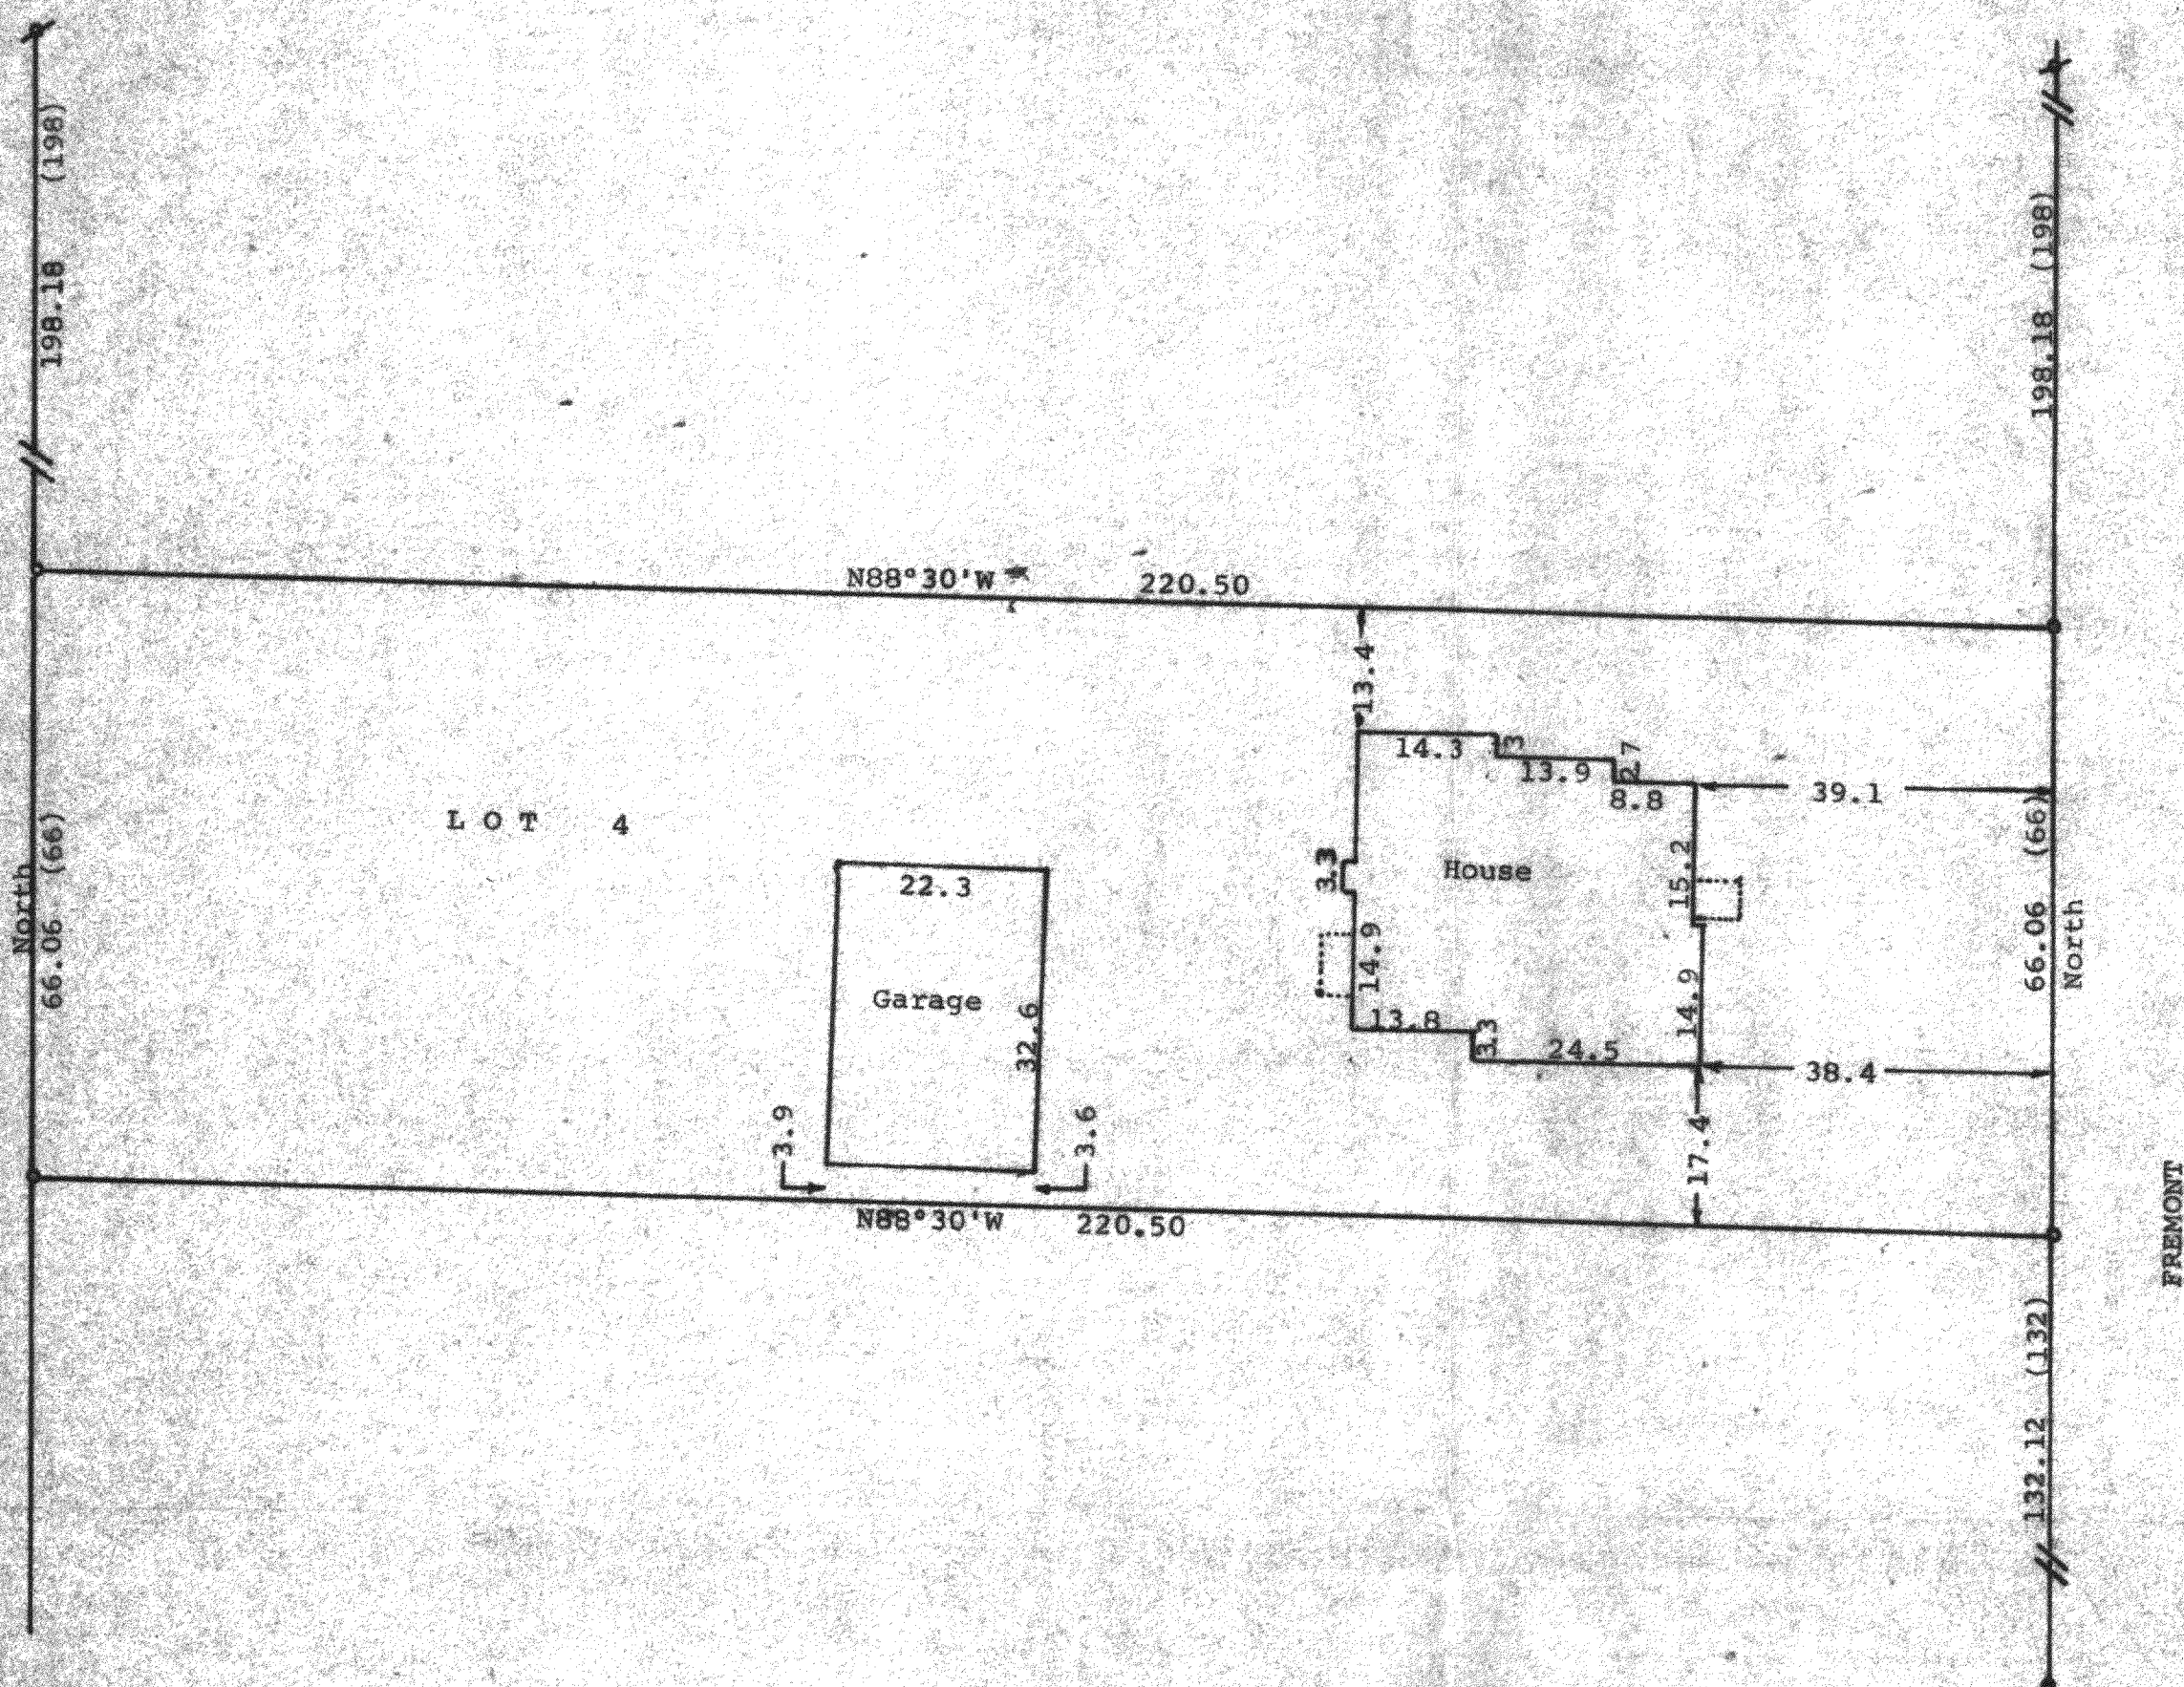


DUNHAM SURVEYING, S.C.
SURVEYING & SUBDIVIDING
DELAVER, WISCONSIN 53115

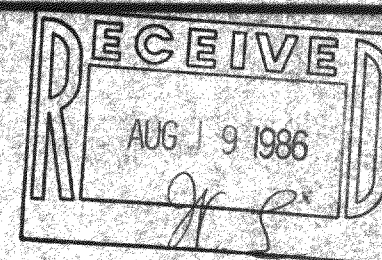

Scale - 1" = 20'

- = 1" Iron Pipe Found
- = 1" X 24" Iron Pipe Set
- = Concrete Monument Found
- (0.00) = recorded distance

Survey ordered by:
Churchill Real Estate
322 Park
Walworth, WI 53184

Bearings are referenced to
the West line of Fremont
Street, assumed bearing of
North.

STATE OF WISCONSIN)
COUNTY OF WALWORTH) SS

I, George T. Dunham, Surveyor, certify that I have surveyed the
property described as follows:

Lot 4 in Phillips Addition to the Village of Walworth, Walworth
County, Wisconsin,

and that the above map is a true representation thereof and shows the size
and location of the property, its exterior boundaries, the location of all
visible structures and dimensions of all principal buildings thereon,
boundary fences, apparent easements, roadways and visible encroachments,
if any, and that I have surveyed the property hereon described according
to the official records to the best of my knowledge and belief.

August 5, 1986

George T. Dunham
George T. Dunham, Surveyor

