

ABELL  
SURVEYING & MAPPING



1140 SEQUOIA STREET • DELAVAN, WISCONSIN 53115  
262-728-6737

LOT 2

S 88°39'42" E 190.92' (191.5')

LOT 3

0.29 ACRES

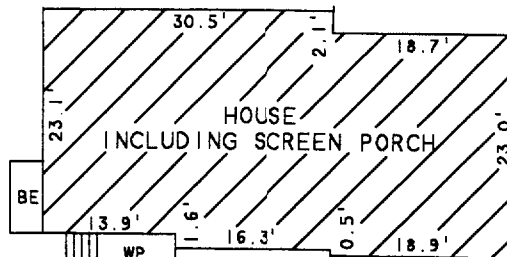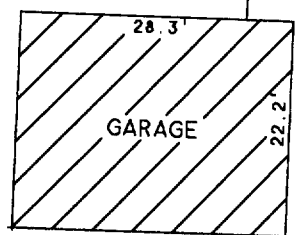

BLACKTOP DRIVE

N 88°34'50" W 190.86' (191.5')

LOT 4

PLAT OF SURVEY OF

LOT 3 OF CLARKES 2ND ADDITION, VILLAGE OF  
WALWORTH, WALWORTH COUNTY, WISCONSIN.

ORDERED BY: RE/MAX GENEVA REALTY, LTD.  
101 BROAD STREET  
LAKE GENEVA, WI 53147

DRR

DRR

RANDOLPH STREET

NOTE: BEARINGS ARE REFERENCED TO  
EXISTING SURVEY RECORDS.



SCALE 1"=20'

LEGEND

- ⊘ - IRON PIPE FOUND
- - SQUARE IRON BAR FOUND
- WP - WOOD PORCH
- BE - BASEMENT ENTRY
- ( ) - RECORDED AS

I HEREBY CERTIFY THAT I HAVE SURVEYED THE ABOVE DESCRIBED PROPERTY AND THAT THE ABOVE MAP IS A TRUE REPRESENTATION THEREOF AND SHOWS THE SIZE AND LOCATION OF THE PROPERTY, ITS EXTERIOR BOUNDARIES, THE LOCATION OF ALL VISIBLE STRUCTURES AND DIMENSIONS OF ALL PRINCIPAL BUILDINGS THEREON, BOUNDARY FENCES, APPARENT EASEMENTS, ROADWAYS AND VISIBLE ENCROACHMENTS, IF ANY, TO THE BEST OF MY KNOWLEDGE AND BELIEF.

THIS SURVEY IS MADE FOR THE USE OF THE PRESENT OWNERS OF THE PROPERTY, AND ALSO THOSE WHO PURCHASE, MORTGAGE, OR GUARANTEE THE TITLE THERETO WITHIN ONE (1) YEAR FROM DATE HEREON.

*David F. Abell*

DAVID F. ABELL  
WISCONSIN REGISTERED LAND SURVEYOR, S-1596

November 13, 2003

DATE JOB NUMBER - 03160  
NOTE: THIS IS NOT A CERTIFIED COPY UNLESS SEALED.

VCA2-3

009-888