

PREPARED FOR
ALLISON OLESTON
SHOREWEST REALTORS
830 E. GENEVA ST.
DELAVER WI. 53115

PLAT OF SURVEY

-OF-



KROTT SURVEYING INC.

N3705 WILLOW BEND LANE
LAKE GENEVA WI. 53147
PHONE # (262)248-3697
FAX # (262)249-0639

LOT 12 OF CLARKE'S 2nd ADDITION TO THE VILLAGE OF
WALWORTH, LOCATED IN TOWN 1 NORTH, RANGE 16
EAST, WALWORTH COUNTY, WISCONSIN.

C.L. RANDOLPH STREET

(57.7' WIDE)

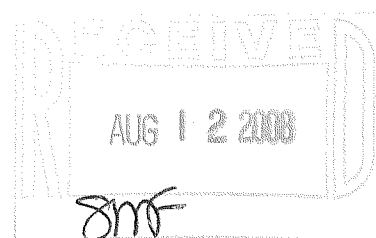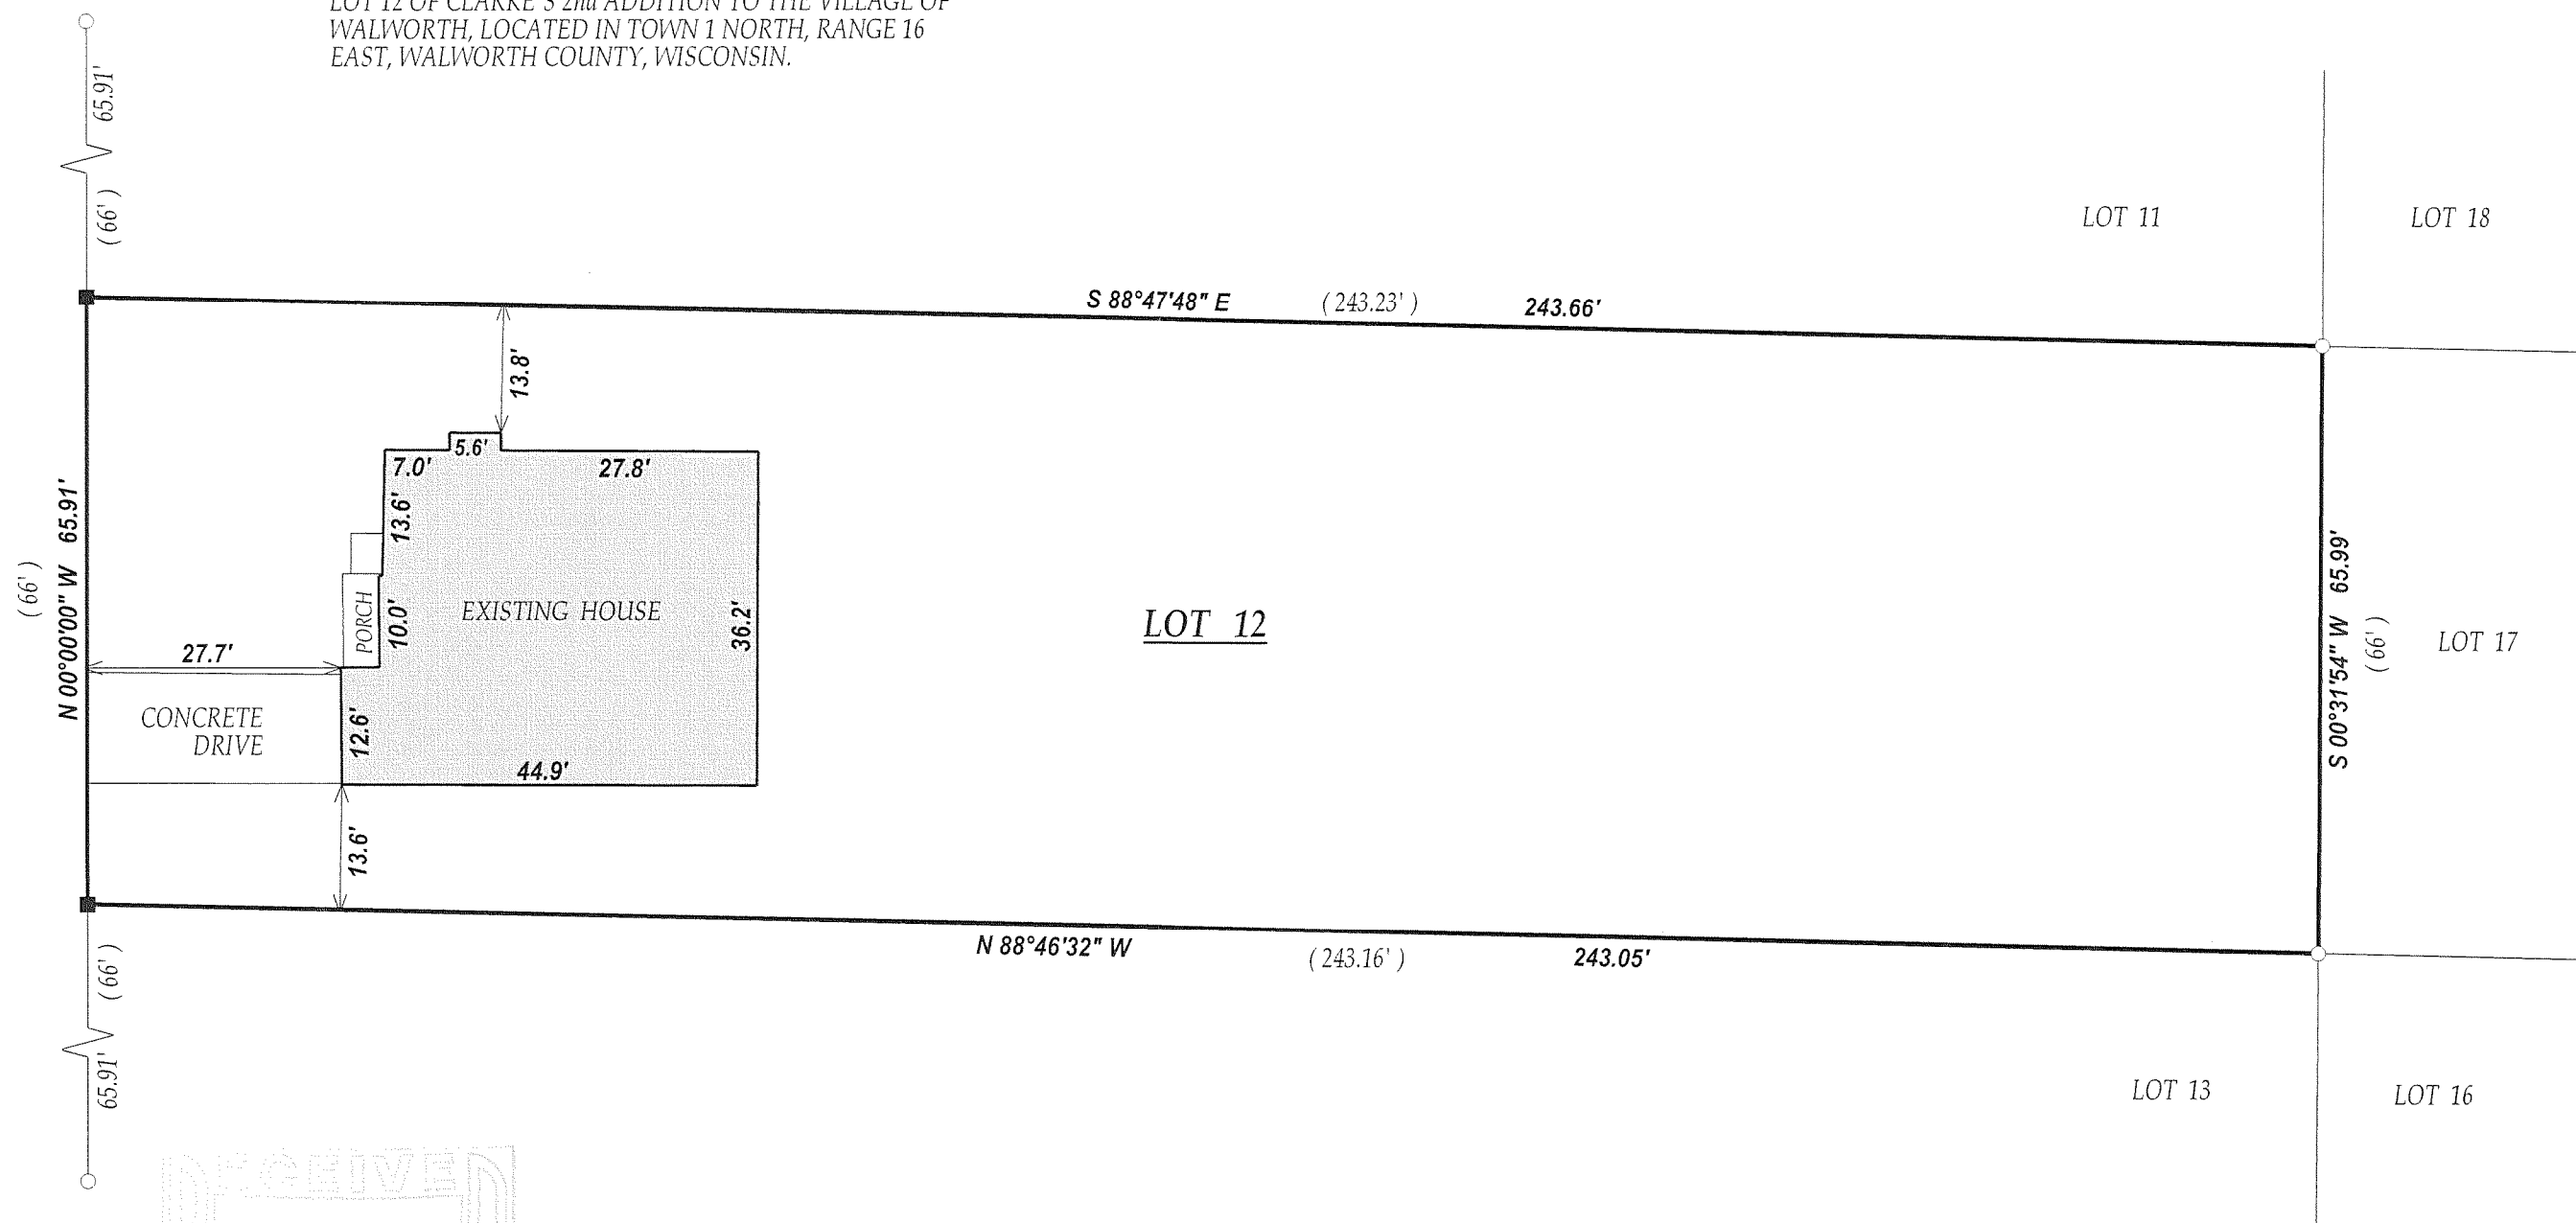


LEGEND

- FOUND IRON PIPE
- SET IRON BAR
- (XX) RECORDED AS

JOB # 08-154 TAX ID # VCA200014


DATED THIS THE 8th DAY OF JULY 2008.

"I hereby certify that I have surveyed the above described property and that the above map is a true representation thereof and shows the size and location of all visible structures, apparent easements and encroachments if any."
This survey is made for the present owners of the property, and those who purchase, mortgage, or guarantee the title thereto, within one year from the date hereof.

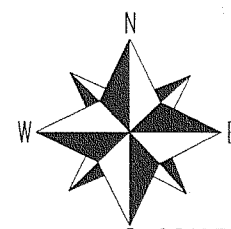

SCALE 1"=20'

0 20 40 60

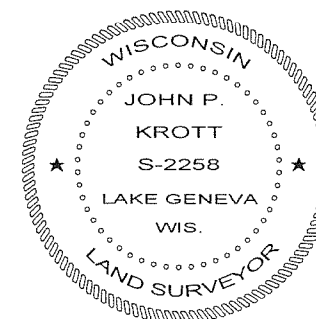

John Krott
JOHN KROTT S - 2258
Wisconsin Registered Land Surveyor
(original if signed in red)

009-1078