


Plat of Survey



of
Lot 10 in Block 1 of Crandall & Swinneys Subdivision,

located in the Northeast 1/4 of Section 21, Town 1 North, Range 16 East, Village of Walworth,
 Walworth County, Wisconsin.

Surveyed for: **Robert Wedell**
 P.O. 32
 Walworth, Wisconsin. 53184

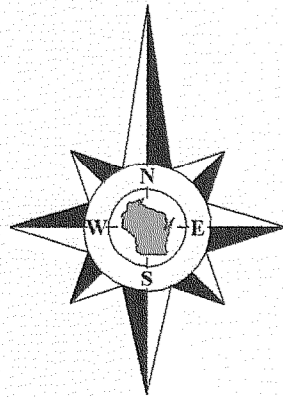


Bearings reference to the West
 line of Weber Street assumed to
 bear North.

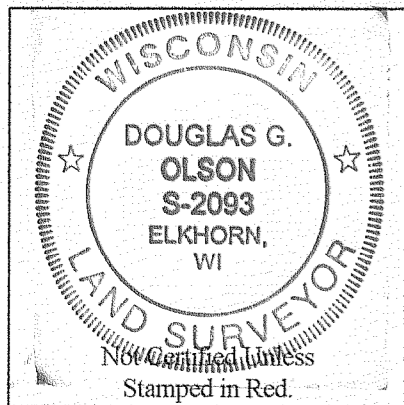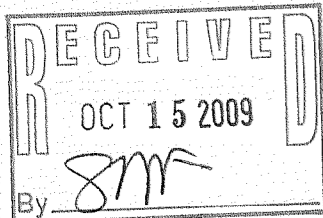

Notes:

- 1) This survey plat is not certified unless signed and sealed in red ink.
- 2) This survey is subject to Wisconsin lien laws. This Plat of Survey is the notice of intent to file lien. Lien waiver required.

VCS - 10

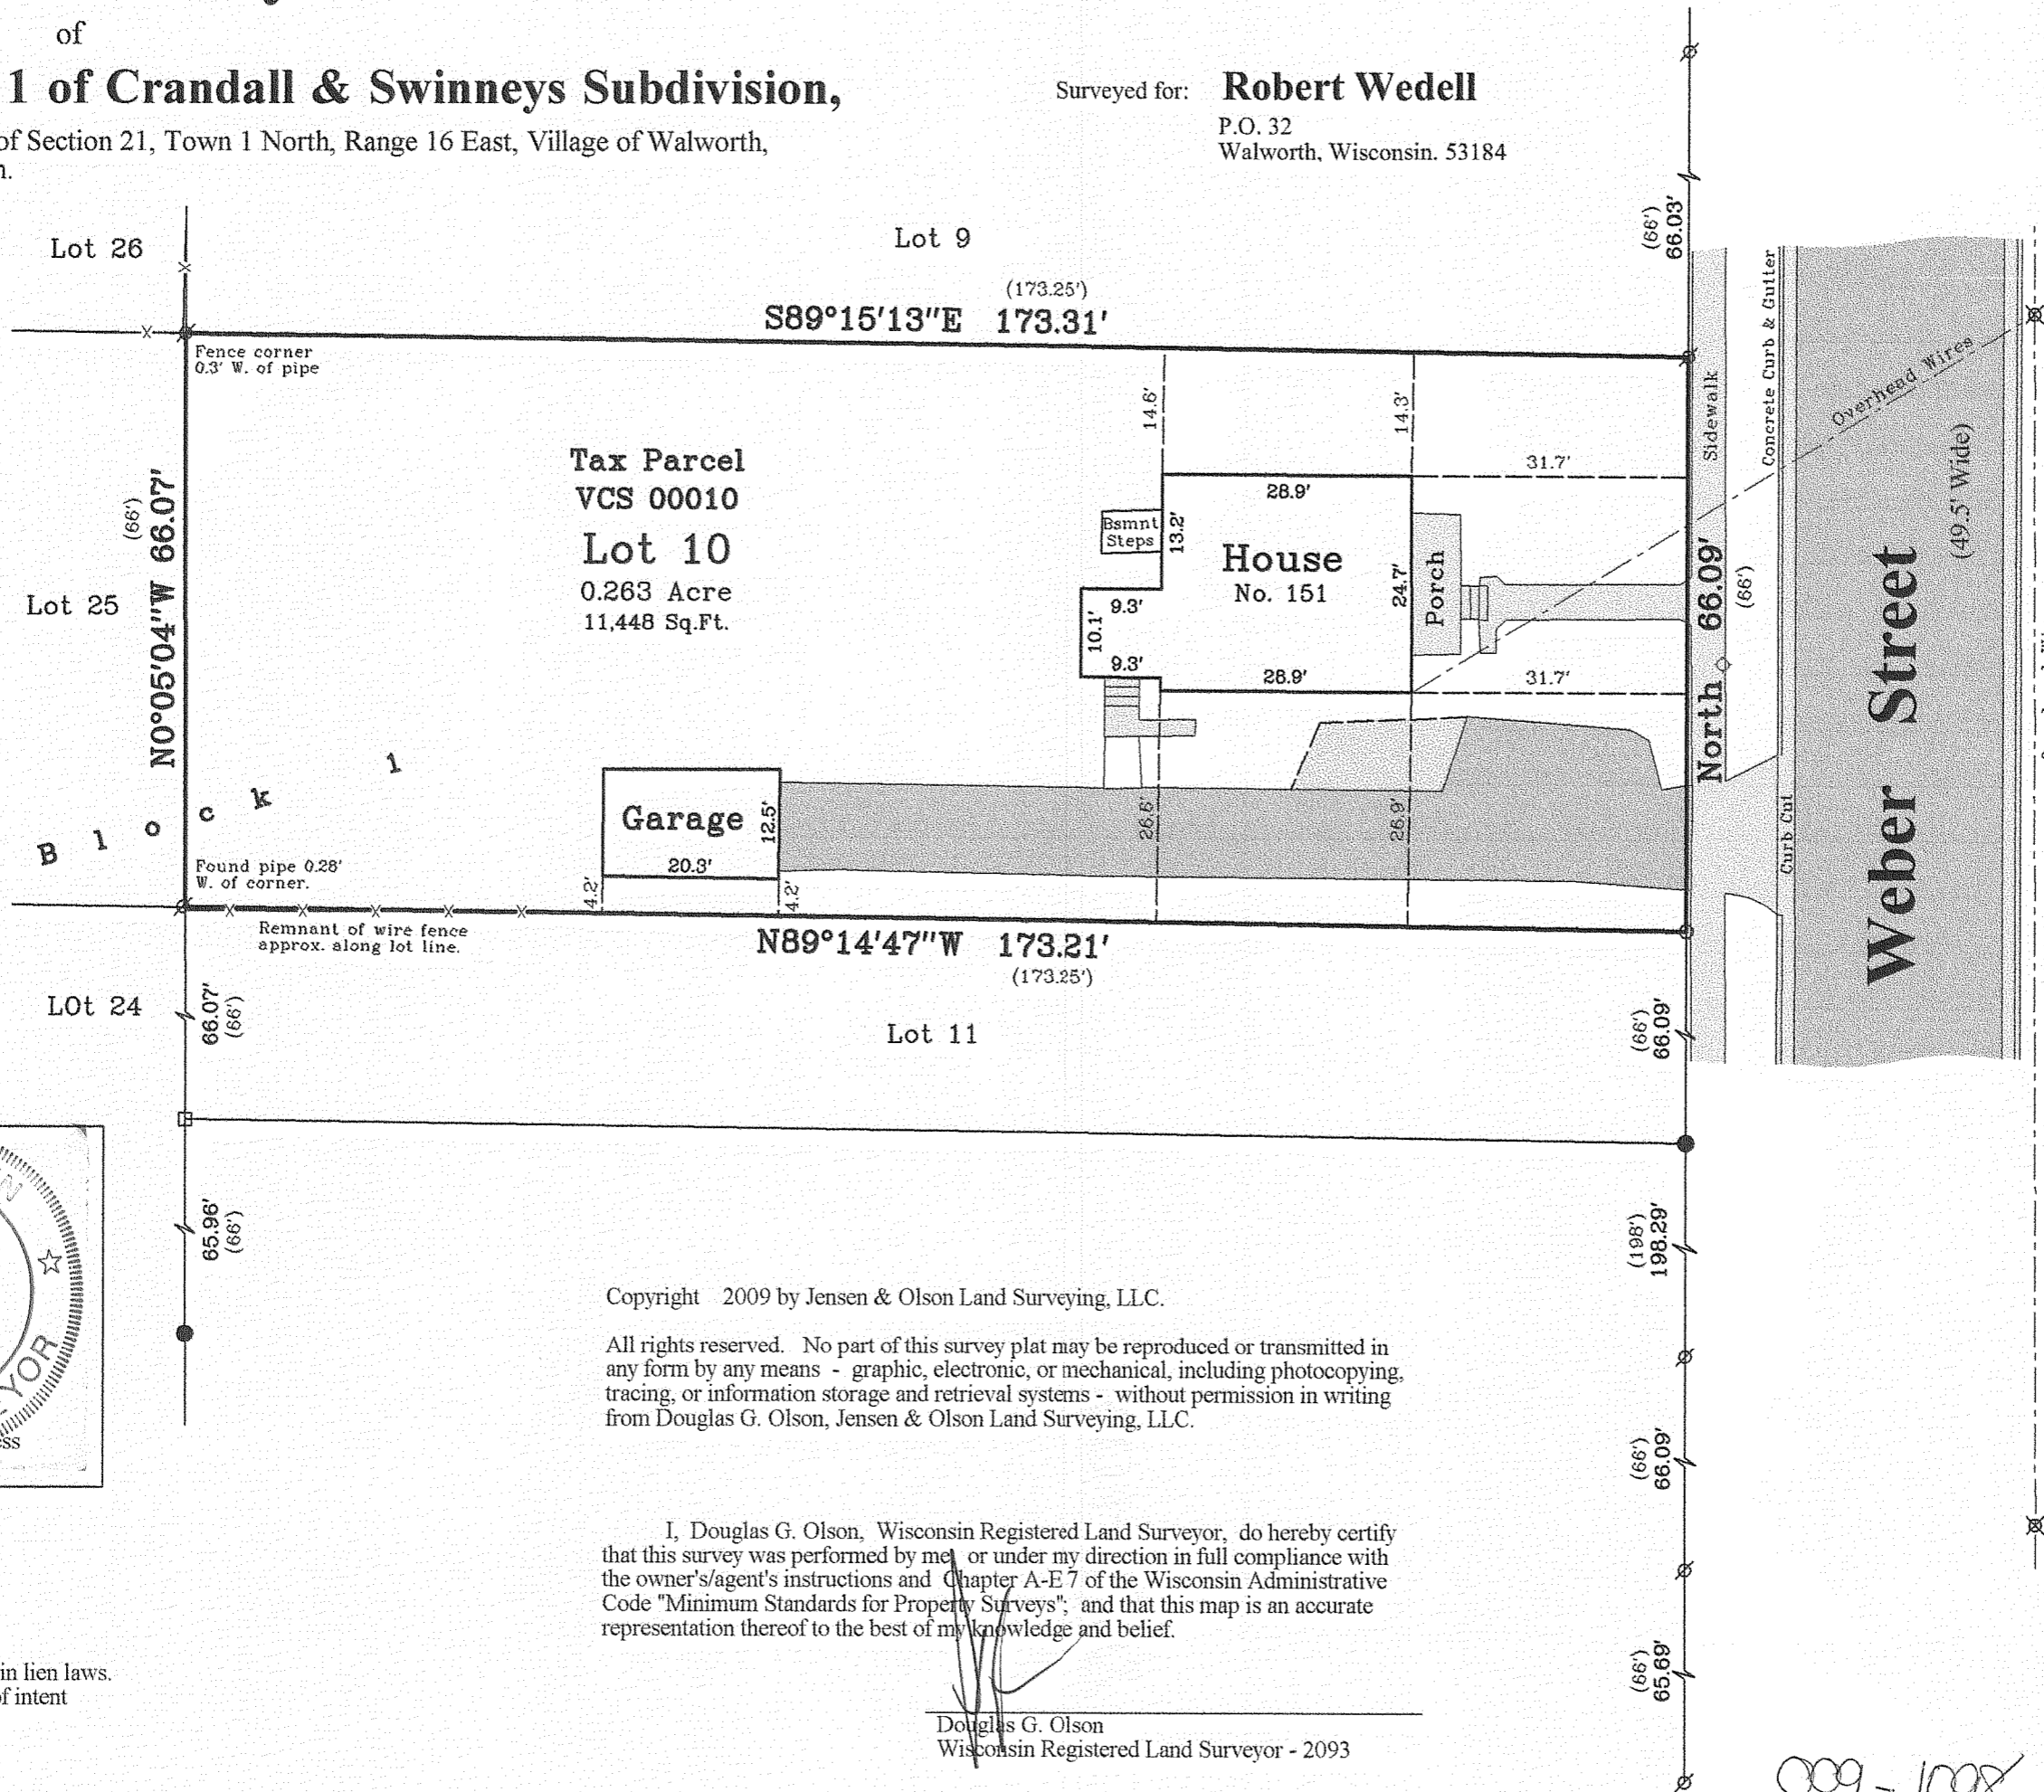

Copyright 2009 by Jensen & Olson Land Surveying, LLC.

All rights reserved. No part of this survey plat may be reproduced or transmitted in any form by any means - graphic, electronic, or mechanical, including photocopying, tracing, or information storage and retrieval systems - without permission in writing from Douglas G. Olson, Jensen & Olson Land Surveying, LLC.

I, Douglas G. Olson, Wisconsin Registered Land Surveyor, do hereby certify that this survey was performed by me, or under my direction in full compliance with the owner's/agent's instructions and Chapter A-E 7 of the Wisconsin Administrative Code "Minimum Standards for Property Surveys", and that this map is an accurate representation thereof to the best of my knowledge and belief.

Douglas G. Olson
 Wisconsin Registered Land Surveyor - 2093

Legend


- Found Iron Pipe
- Found Iron Rod
- Found Axle
- Set Iron Rod, 3/4" dia.
- Recorded Information
- Utility Pole
- Asphalt Surface
- Concrete Surface
- Gravel Surface

Jensen & Olson Land Surveying, LLC

45 South Wisconsin Street * P.O. Box 322 * Elkhorn, Wisconsin. 53121

Telephone: (262) 723-3434 * Facsimile: (262) 723-8044

Email: jensen.olson@elknet.net

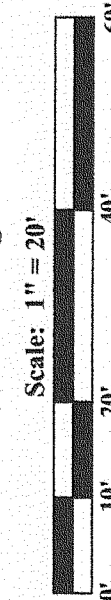

Survey date: July 16, 2009.
 Revisions:

Sheet 1 of 1 Sheets.
 Job Reference Number:
2009.044

009-1098