ENGINEERING — ARCHITECTURE — SURVEYING 7 RIDGWAY COURT — P.O. BOX 437 — ELKHORN, WISCONSIN 53127 PHONE: (262) 723—2098 FAX: (262) 723—5886

PLAT OF SURVEY

LOT 68 OF OAK KNOLLS OF WALWORTH ADD. 1

WORK ORDERED BY THE RAULAND AGENCY
118 KENOSHA STREET
WALWORTH, WI. 53184

Lot 68, Oak Knolls of Walworth Addition No. 1, a resubdivision of Outlot No. 1 of Oak Knolls of Walworth being a Subdivision of the Southeast 1/4 of the Southeast 1/4 of Section 22, Town 1 North, Range 16 East, in the Village of Walworth, County of Walworth, State of Wisconsin.


Tax Key No: VOK1 00041

OF LOT

THE EAST LINE S 01D10'47" W


ASSIGNED

DEVILS LANE

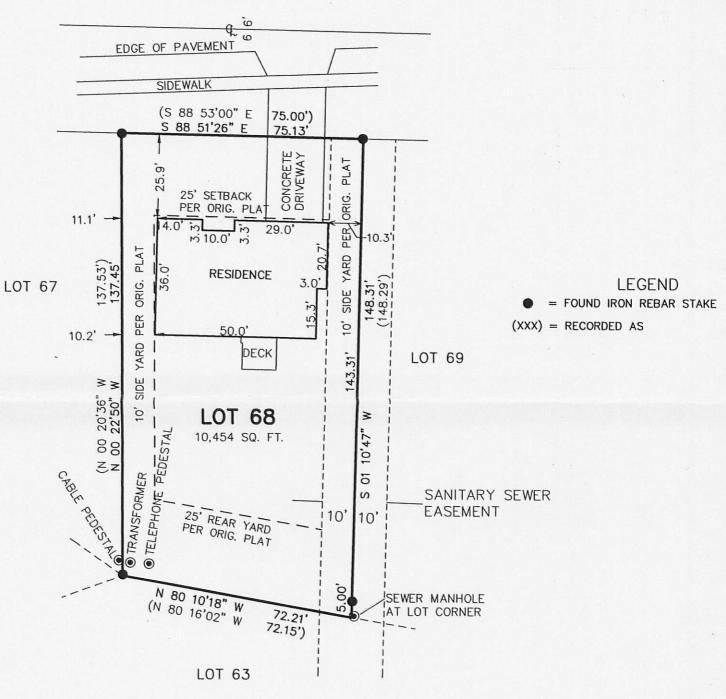

100 90 80 70 60 50 40 30 20 10 50 MAP SCALE IN FEET ORIGINAL 1" = 30'

CHICAGO TITLE INSURANCE COMMITMENT NO. 435912 REFERENCES AN EASEMENT IN EXCEPTION 15 AS DOCUMENT NUMBER 344144. SAID EASEMENT IS RECORDED AS THAT DOCUMENT NUMBER IN VOL. 271 OF DEEDS (NOT RECORDS) ON PAGE 316 (NOT 315). SAID EASEMENT LIES WITHIN THE RIGHT OF WAY FOR DEVILS LANE ALLOWING FOR POWER POLES.

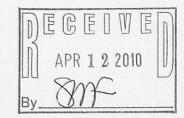

NOTE: COPIES OF THIS MAP TO WHICH THE FOLLOWING CERTIFICATE WILL APPLY SHOW SURVEYOR'S ORIGINAL SEAL AND SIGNATURE IN RED INK. COPIES BY ANY OTHER MEANS MAY HAVE ALTERATIONS WHICH DO NOT REPRESENT THE SURVEYOR'S WORK PRODUCT.

I HEREBY CERTIFY THAT THE ABOVE DESCRIBED PROPERTY HAS BEEN SURVEYED UNDER MY DIRECTION AND THAT THE ABOVE MAP IS A TRUE REPRESENTATION THEREOF AND SHOWS THE SIZE AND LOCATION OF THE PROPERTY, ITS EXTERIOR BOUNDARIES, THE LOCATION OF ALL VISIBLE STRUCTURES, AND DIMENSIONS OF ALL PRINCIPLE BUILDINGS THEREON, BOUNDARY FENCES, APPARENT EASEMENTS, ROADWAYS, AND VISIBLE ENCROACHMENTS, IF ANY. THIS SURVEY IS MADE FOR THE USE OF THE PRESENT OWNERS OF THE PROPERTY, AND ALSO THOSE WHO PURCHASE, MORTGAGE, OR GUARANTEE THE TITLE THERETO WITHIN ONE YEAR FROM THE DATE HEREOF.

DATED: MARCH 17, 2010

PETER S. GORDON R.L.S. 2101



PROJECT: 8087 DATE: 03-17-2010

SHEET 1 OF 1

3/17/2010 X: \Projects\8087\dcad\survey

MAR 17 2018. VOVI