

ALTA/ACSM LAND TITLE SURVEY

Known as 121-129 Allen Street, in the Village of Walworth, Walworth County, Wisconsin.

Out Lot 61 of the Assessor's Plat of the Village of Walworth, Walworth County, Wisconsin, as recorded in Volume 11 of Plats on Page 14, excepting therefrom the North 198 feet, further excepting the easterly eight (8) feet of the southerly 478.50 feet, said parcel is located in the Southeast 1/4 of Section 21, T1N, R16E, situated in the County of Walworth and State of Wisconsin.

Prepared for: Charles Walter


Survey No.165198-CRW

To: Village Apartments, LLC
Associated Bank, National Association, its successors and/or assigns
Chicago Title Insurance Company



This is to certify that this map or plat and the survey on which it is based were made in accordance with the 2011 Minimum Standard Detail Requirements for ALTA/ACSM Land Title Surveys, jointly established and adopted by ALTA and NSPS and includes items 1, 2, 3, 4, 6(a), 7(a), 7(c), 8, 9, and 11(a) of Table A thereof. The field work was completed on July 22, 2011.

Date of Plat or Map: July 25, 2011

John P. Casucci
Registered Land Surveyor
Registration Number S-2056

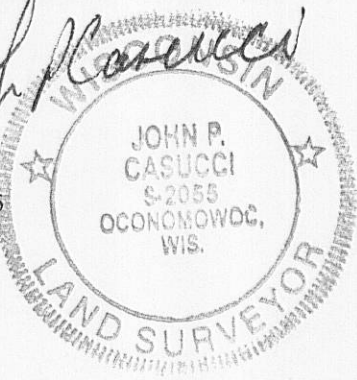

VICINITY MAP
NOT TO SCALE

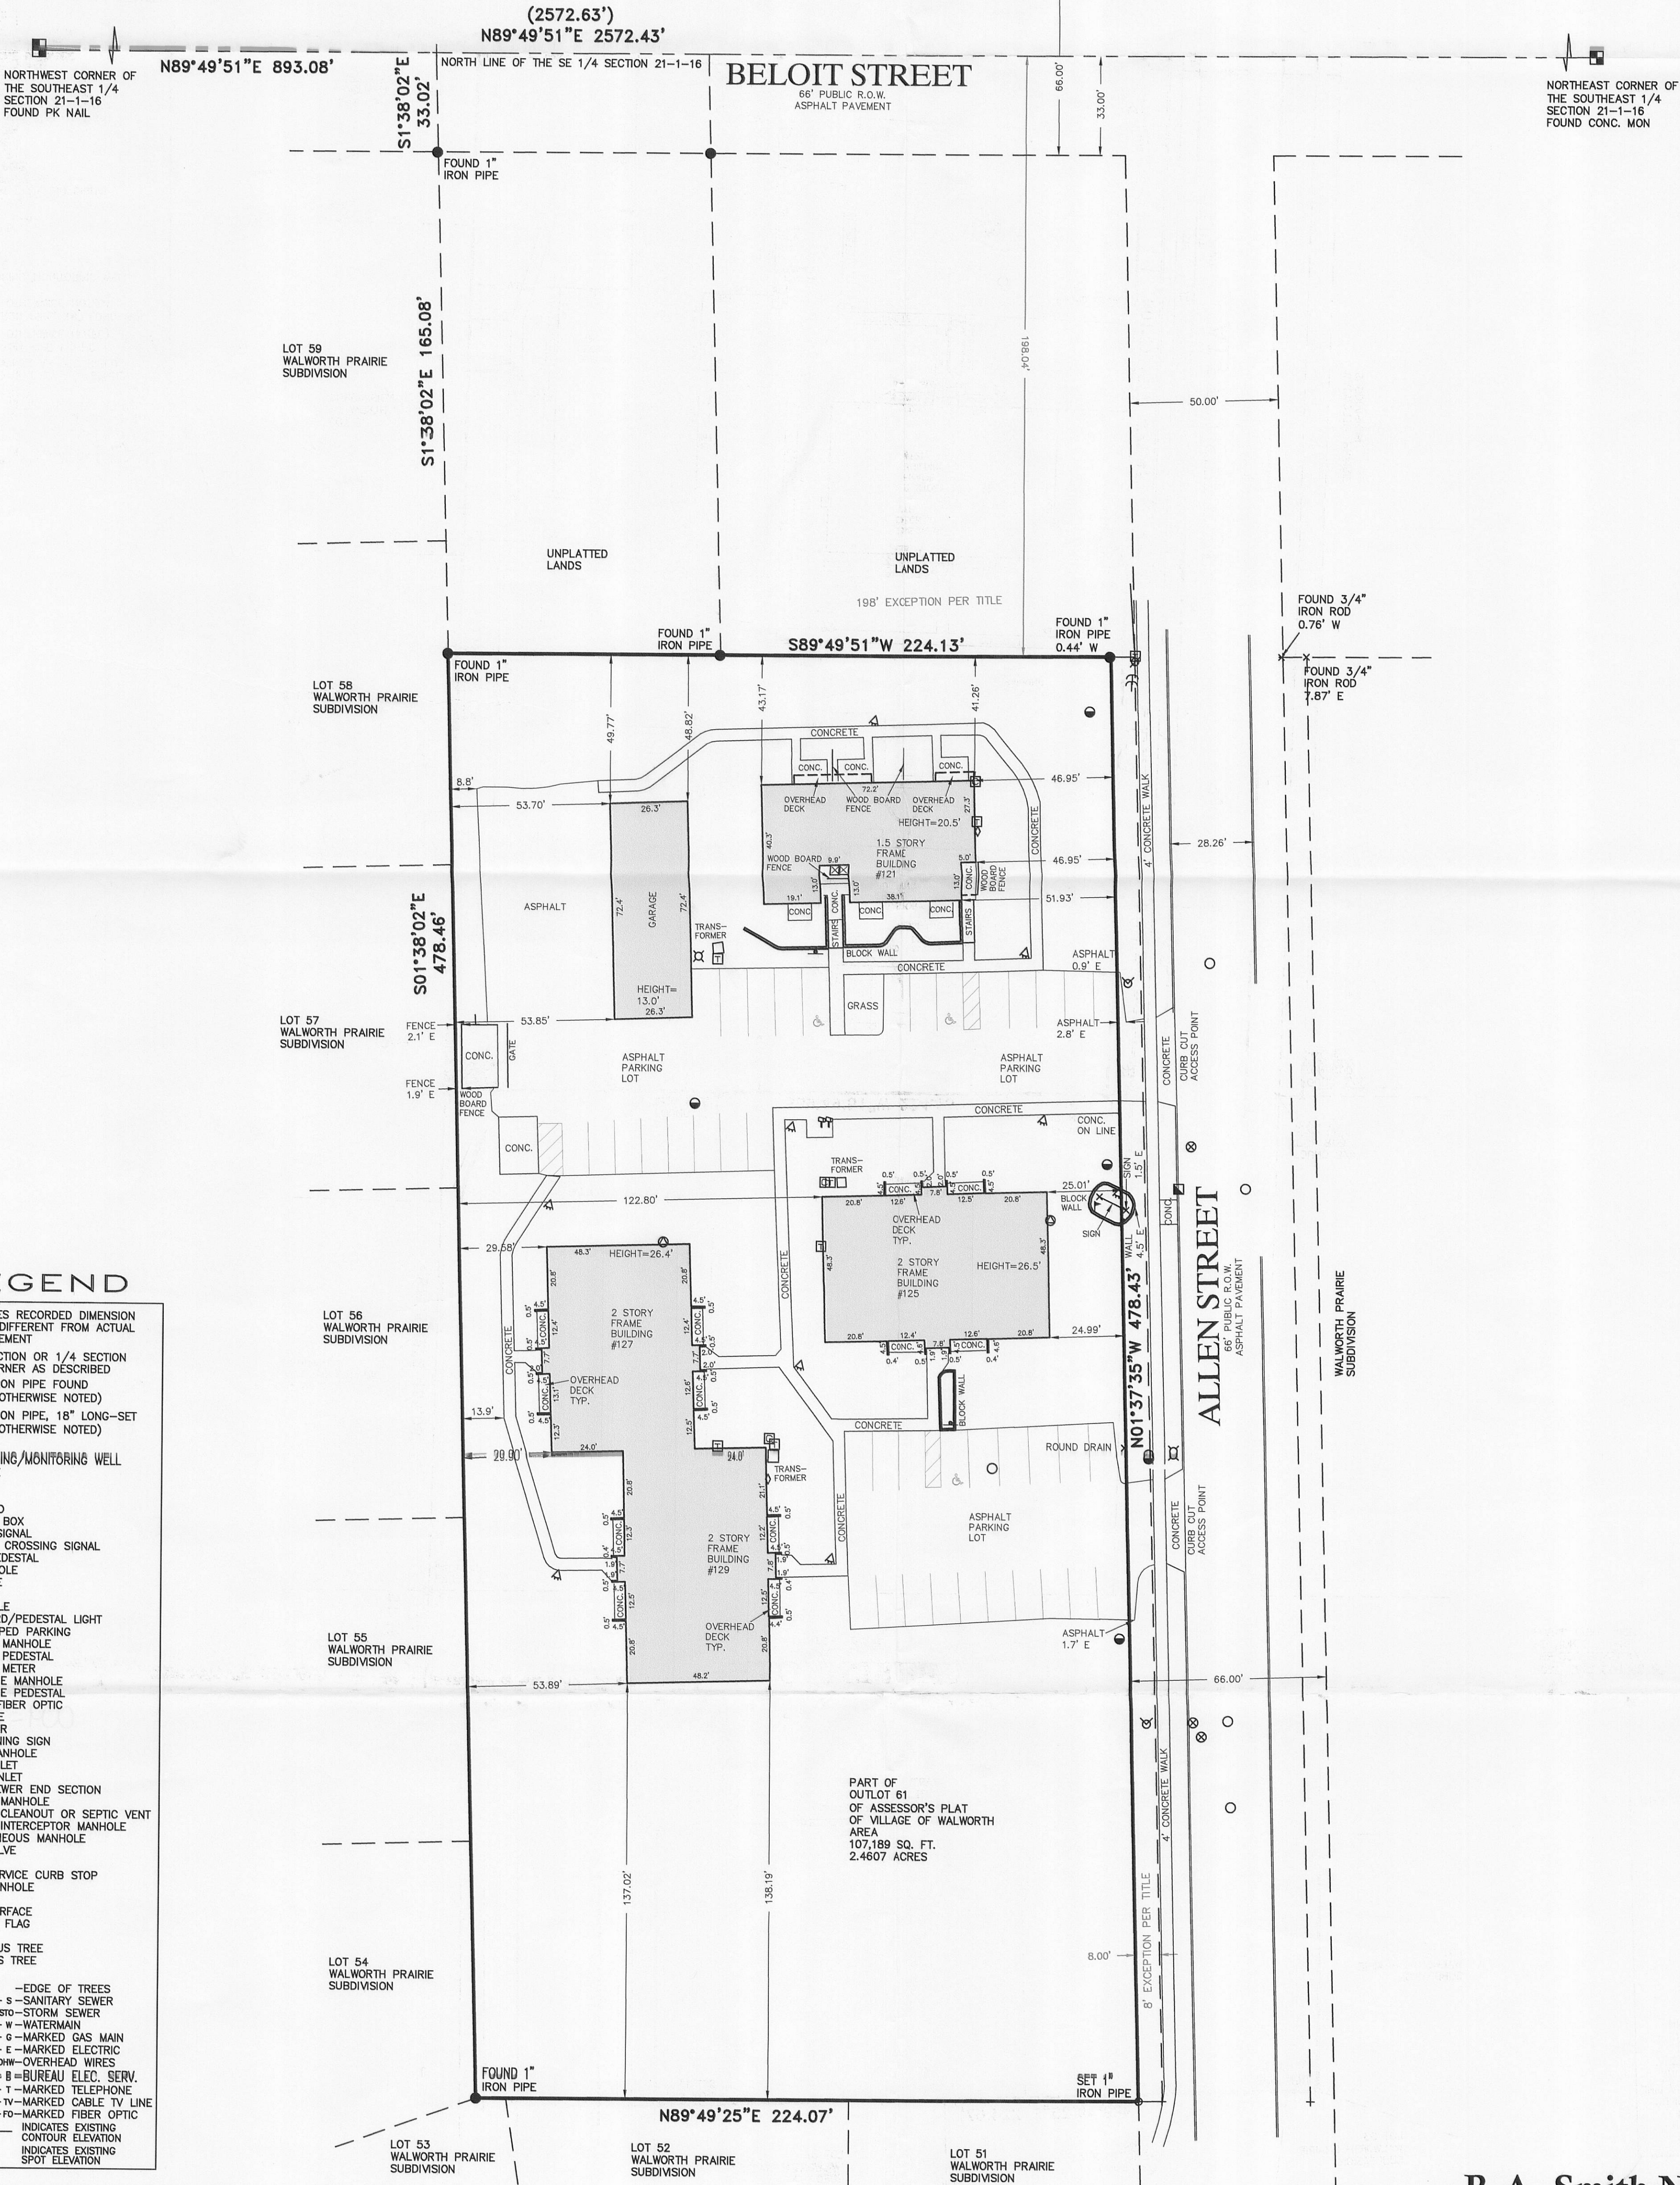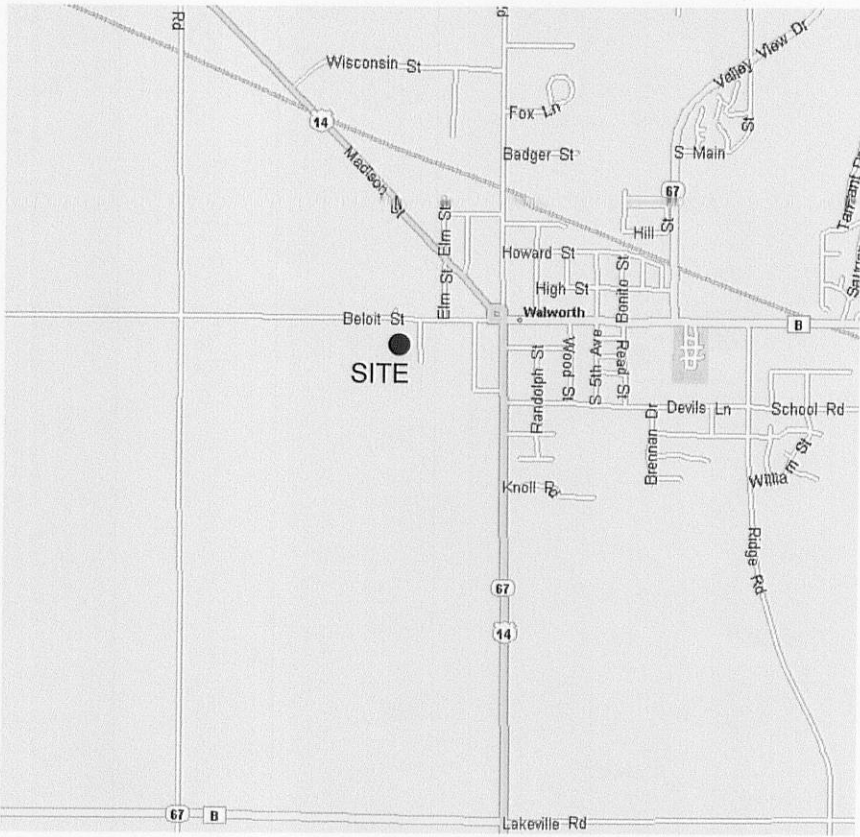

R.A. Smith National, Inc.

Beyond Surveying
and Engineering

16745 W. Bluemound Road, Brookfield WI 53005-5938
262.761-1000 Fax 262.761-7373, www.ra-smithnational.com
Appleton, WI Orange County, CA Pittsburgh, PA
S:\S165198\dwg\ AS101D30.dwg \ AS101D30