

FARRIS, HANSEN & ASSOCIATES, INC.

ENGINEERING — ARCHITECTURE — SURVEYING
7 RIDGWAY COURT — P.O. BOX 437 — ELKHORN, WISCONSIN 53121
PHONE: (262) 723-2098 FAX: (262) 723-5886

PERMIT PLAT

LOT 16, BLOCK 2 OF BIGFOOT RIDGE OF WALWORTH ADDITION NO. 2
LOCATED IN THE SW 1/4 AND SE 1/4 OF SECTION 22, TOWN 1 NORTH,
RANGE 16 EAST, VILLAGE OF WALWORTH, WALWORTH COUNTY, WISCONSIN

Lot 16 in Block 2 of Big Foot Ridge of Walworth Addition No. 2 recorded March 14, 2002 in Cabinet C, Slide 118 as Document No. 503713, located in the SE 1/4 of the SW 1/4 and the SW 1/4 of the SE 1/4 of Section 22, T1N, R16E, Walworth County, Wisconsin.

Tax Key No: VBIG2 00008

EDGE OF PAVEMENT

SUMMER DRIVE

66' WIDE R.O.W.

SIDEWALK

86.99

N 89°51'26" E

25' STREET YARD

CONCRETE DRIVEWAY

12.0'

AS BUILT FOUNDATION

BRICK PATIO

25' REAR YARD


FOUND IRON PIPE
0.25' NORTH

N 84°33'39" W
92.73

6' UTIL. EASE.

20' DRAINAGE EASEMENT

MAP SCALE IN FEET ORIGINAL 1" = 20'

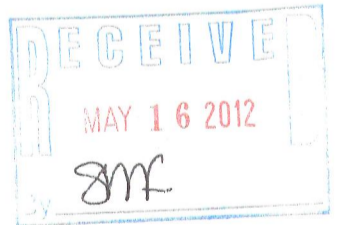

— WORK ORDERED BY —
THE RAULAND AGENCY
118 KENOSHA STREET
WALWORTH, WI. 53184

LEGEND

- = FOUND IRON PIPE STAKE
- = FOUND IRON REBAR STAKE
- = SET IRON REBAR STAKE
- (xxx) = RECORDED AS

NOTE: COPIES OF THIS MAP TO WHICH THE FOLLOWING CERTIFICATE WILL APPLY SHOW THE SURVEYOR'S ORIGINAL SEAL AND SIGNATURE IN RED INK. COPIES BY ANY OTHER MEANS MAY HAVE ALTERATIONS WHICH DO NOT REPRESENT THE SURVEYOR'S WORK PRODUCT.

I HEREBY CERTIFY THAT THE ABOVE DESCRIBED PROPERTY HAS BEEN SURVEYED UNDER MY DIRECTION AND THAT THE ABOVE MAP IS A TRUE REPRESENTATION THEREOF AND SHOWS THE SIZE AND LOCATION OF THE PROPERTY, ITS EXTERIOR BOUNDARIES, THE LOCATION OF ALL VISIBLE STRUCTURES, AND DIMENSIONS OF ALL PRINCIPLE BUILDINGS THEREON, BOUNDARY FENCES, APPARENT EASEMENTS, ROADWAYS, AND VISIBLE ENCROACHMENTS, IF ANY. THIS SURVEY IS MADE FOR THE USE OF THE PRESENT OWNERS OF THE PROPERTY, AND ALSO THOSE WHO PURCHASE, MORTGAGE, OR GUARANTEE THE TITLE THERETO WITHIN ONE YEAR FROM THE DATE HEREOF.

DATED: MARCH 28, 2012

PETER S. GORDON



PROJECT: 6645
DATE: 09/21/2004
SHEET 1 OF 1

MAR 28 2012 VBIG2-8

009-1137