

LAND-MARK SURVEYING

Mark L. Miritz


Wisconsin Registered Land Surveyor S-2582

N9330 Knuteson Drive
Whitewater, WI 53190
Phone: (262) 495-3284
FAX: (262) 495-8421
LAND-MARKSURVEYING.COM

ORDERED BY:
HARRY MOHR
RAULAND AGENCY, INC.
118 KENOSHA STREET
WALWORTH, WI 53184

PLAT OF SURVEY

LOT 5 IN BLOCK 4 OF BIGFOOT RIDGE OF WALWORTH ADDITION
NO. 1, LOCATED IN SECTION 22, TOWN 1 NORTH, RANGE 16 EAST,
VILLAGE OF WALWORTH, WALWORTH COUNTY, WISCONSIN.

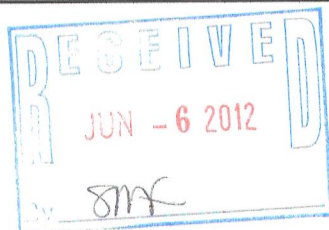

AUTUMN DRIVE

(66' WIDE)

6' WIDE UTILITY EASEMENT

LOT 4
BLOCK 4

LOT 5
12,006 SQ. FT.

LOT 6

TIMBER RETAINING WALL 5.5' SO. OF LINE

BRICK RETAINING WALL

CORNER FALLS ON BRICK
RETAINING WALL SET IRON
ROD 1.0' NORTH OF CORNER
ON LINE



LEGEND

- FOUND IRON PIPE 1 1/4"
- FOUND IRON ROD 3/4"
- FOUND COUNTY MONUMENT
- FOUND IRON PIPE 2"
- SET CUT CROSS IN CONCRETE
- SET IRON ROD, 18" LONG, WEIGHING
1.5 LBS./LINEAL FT., 3/4" DIA.
- RECORDED AS DIMENSION
- FOUND CHISEL CUT IN CONCRETE

SCALE: 1 INCH = 30 FEET

"I hereby certify that the above described property has
been surveyed by me or under my direction and that the
above map is a true representation thereof and shows the
size and location of the property, its exterior boundaries,
the location of all visible structures and dimensions of all
principal buildings thereon, boundary fences, apparent
easements, roadways and visible encroachments, if any."
"This survey is made for the use of the present owners of
the property, and also those who purchase, mortgage, or
guarantee the title thereto within one year from date
hereof."

MARK L. MIRITZ
WISCONSIN REGISTERED
LAND SURVEYOR S-2582

DATE: APRIL 2, 2012 JOB NO. 12.305

VBIG1-15

009 - 1142