FARRIS, HANSEN & ASSOCIATES, INC.


ENGINEERING - ARCHITECTURE - SURVEYING 7 RIDGWAY COURT - P.O. BOX 437 - ELKHORN, WISCONSIN 53121 PHONE: (262) 723-2098 FAX: (262) 723-5886

PLAT OF SURVEY

LOT 16 OF LIBRARY SQUARE

THE TRACY GROUP 1157 S. WELLS STREET, UNIT 10 LAKE GENEVA, WI 53147 A SUBDIVISION LOCATED IN PART OF THE NE 1/4 OF THE SW 1/4 AND

WORK ORDERED BY -

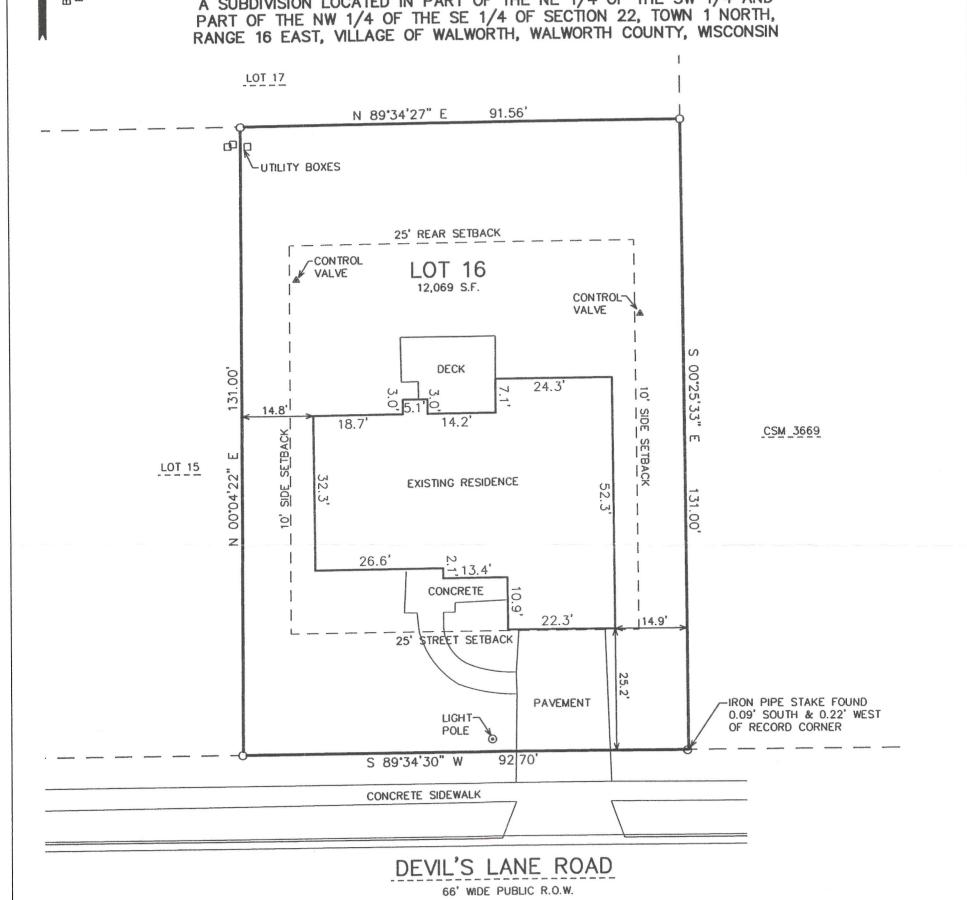

100 10 5 50 70 80 90 40 10 luuluu MAP SCALE IN FEET ORIGINAL = 20'

NOTE: COPIES OF THIS MAP TO WHICH THE FOLLOWING CERTIFICATE WILL APPLY SHOW THE SURVEYOR'S ORIGINAL SEAL AND SIGNATURE IN RED INK. COPIES BY ANY OTHER MEANS MAY HAVE ALTERATIONS WHICH DO NOT REPRESENT THE SURVEYOR'S WORK

I HEREBY CERTIFY THAT THE ABOVE DESCRIBED PROPERTY HAS BEEN SURVEYED UNDER MY DIRECTION AND THAT THE ABOVE MAP IS A TRUE REPRESENTATION THEREOF AND SHOWS THE SIZE AND LOCATION OF THE PROPERTY, ITS EXTERIOR BOUNDARIES, THE LOCATION OF ALL VISIBLE STRUCTURES, AND DIMENSIONS OF ALL PRINCIPLE BUILDINGS THEREON, BOUNDARY FENCES, APPARENT EASEMENTS, ROADWAYS, AND VISIBLE ENCROACHMENTS, IF ANY. THIS SURVEY IS MADE FOR THE USE OF THE PRESENT OWNERS OF THE PROPERTY, AND ALSO THOSE WHO PURCHASE, MORTGAGE, OR CUARANTEE THE TITLE THERETO WITHIN ONE YEAR FROM THE DATE HEREOF.

DATED: JULY 26, 2012

\Projects\8311\8311_EAST\dcad\LOT16

/2012

PETER S. GORDON



-SANITARY MANHOLE

GORDON S-2101 ELKHORN,

LEGEND

O = IRON PIPE STAKE FOUND

 $\{XXX\}$ = RECORDED AS

PROJECT: 8311.EAST DATE: 7/26/2012

SHEET 1 OF 1