
GEORGE T. DUNHAM SURVEYING & SUBDIVIDING DELAVAN, WISCONSIN

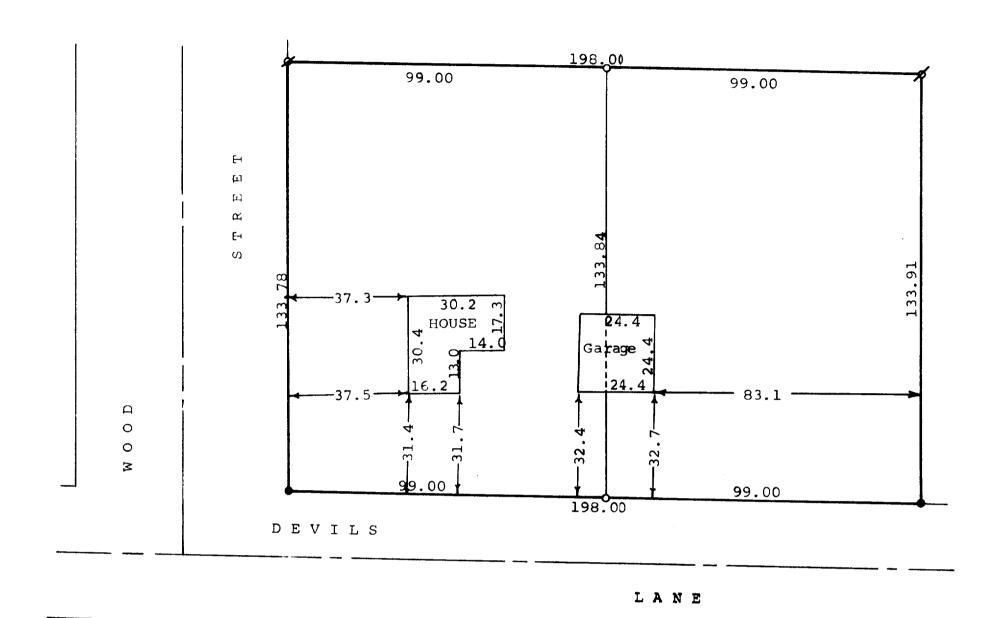

Scale - 1" = 30'**∅** = Iron Pipe Found • = Concrete Monument Found

• = Iron Pipe Set

STATE OF WISCONSIN) SS COUNTY OF WALWORTH)

I, George T. Dunham, Surveyor, certify that I have surveyed the property described as follows,

The South 1/2 of Outlot 216 of the Assessors Plat located in the Northwest 4 of the Southwest 4 of Section 22, T 1 N, R 16 E, Village of Walworth, Walworth County, Wisconsin,

and the above map is a true representation thereof and shows the size and location of the property, its exterior boundaries, the location and dimensions of all structures thereon, fences, apparent easements and roadway and there are no visible encroachments. September 23, 1974

George C. Dunham, Surveyor



NOP-283, 283A

K & E 10-8188 250-7-78