## FARRIS, HANSEN & ASSOCIATES, INC.

ENGINEERING - ARCHITECTURE - SURVEYING
7 RIDGWAY COURT - P.O. BOX 437 - ELKHORN, WISCONSIN 53121
PHONE: (262) 723-2098 FAX: (262) 723-5886

- WORK ORDERED BY -THE RAULAND AGENCY PO BOX 159 WALWORTH, WI. 53184

**LEGEND** 

O = FOUND IRON PIPE STAKE

= FOUND IRON REBAR STAKE

ASSIGNED NORTH LINE KENOSHA STREET

S 90°00'00" W


(XXX) = RECORDED AS

A parcel of land located in the NW ¼ of Section 22, T1N, R16E, Village of Walworth, Walworth County, Wisconsin, described as follows: Beginning at a point that is located 66 rods East of the West ¼ Section corner of Section 22, T1N, RI6E, of Walworth County, Wisconsin; thence North 20 rods; thence East 4 rods; thence South 20 rods; thence West 4 rods to the place of beginning.

PLAT OF SURVEY

The above described premises are more particularly described as follows, to-wit: Outlot 180 of the Assessors Plat to the Village of Walworth according to the recorded plat thereof, Walworth County, Wisconsin.

Tax Key No.: VWP 00210

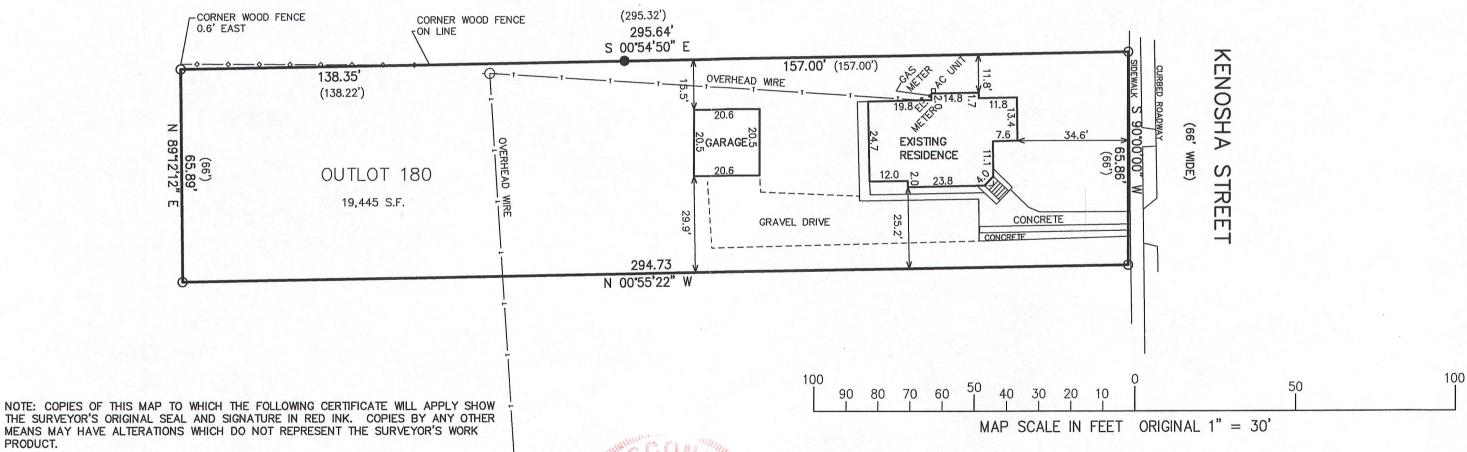

MEANS MAY HAVE ALTERATIONS WHICH DO NOT REPRESENT THE SURVEYOR'S WORK PRODUCT.

I HEREBY CERTIFY THAT THE ABOVE DESCRIBED PROPERTY HAS BEEN SURVEYED UNDER MY DIRECTION AND THAT THE ABOVE MAP IS A TRUE REPRESENTATION THEREOF AND

MY DIRECTION AND THAT THE ABOVE MAP IS A TRUE REPRESENTATION THEREOF AND SHOWS THE SIZE AND LOCATION OF THE PROPERTY, ITS EXTERIOR BOUNDARIES, THE LOCATION OF ALL VISIBLE STRUCTURES, AND DIMENSIONS OF ALL PRINCIPLE BUILDINGS THEREON, BOUNDARY FENCES, APPARENT EASEMENTS, ROADWAYS, AND VISIBLE ENCROACHMENTS, IF ANY. THIS SURVEY IS MADE FOR THE USE OF THE PRESENT OWNERS OF THE PROPERTY, AND ALSO THOSE WHO PURCHASE, MORTGAGE, OR GUARANTEE THE TITLE THERETO WITHIN ONE YEAR FROM THE DATE HEREOF.

DATED: APRIL 21, 2015

PETER S. GORDON P.L.S. 2101



PROJECT: 9269 DATE: 04-21-2015 SHEET 1 OF 1