

FARRIS, HANSEN & ASSOCIATES, INC.


ENGINEERING — ARCHITECTURE — SURVEYING
7 RIDGWAY COURT — P.O. BOX 437 — ELKHORN, WISCONSIN 53121
PHONE: (262) 723-2098 FAX: (262) 723-5886

PLAT OF SURVEY PART OF THE NW 1/4 OF THE SW 1/4 SEC. 22 TOWN 1 NORTH, RANGE 16 EAST WALWORTH COUNTY, WISCONSIN

— WORK ORDERED BY —
RASMUSSEN LAW OFFICE
113 KENOSHA STREET
WALWORTH, WI. 53184

ASSIGNED SOUTH LINE MAPLE STREET
N 00°00'00" E

SOUTH MAIN STREET
AKA S.T.H. 67
(66' WIDE)

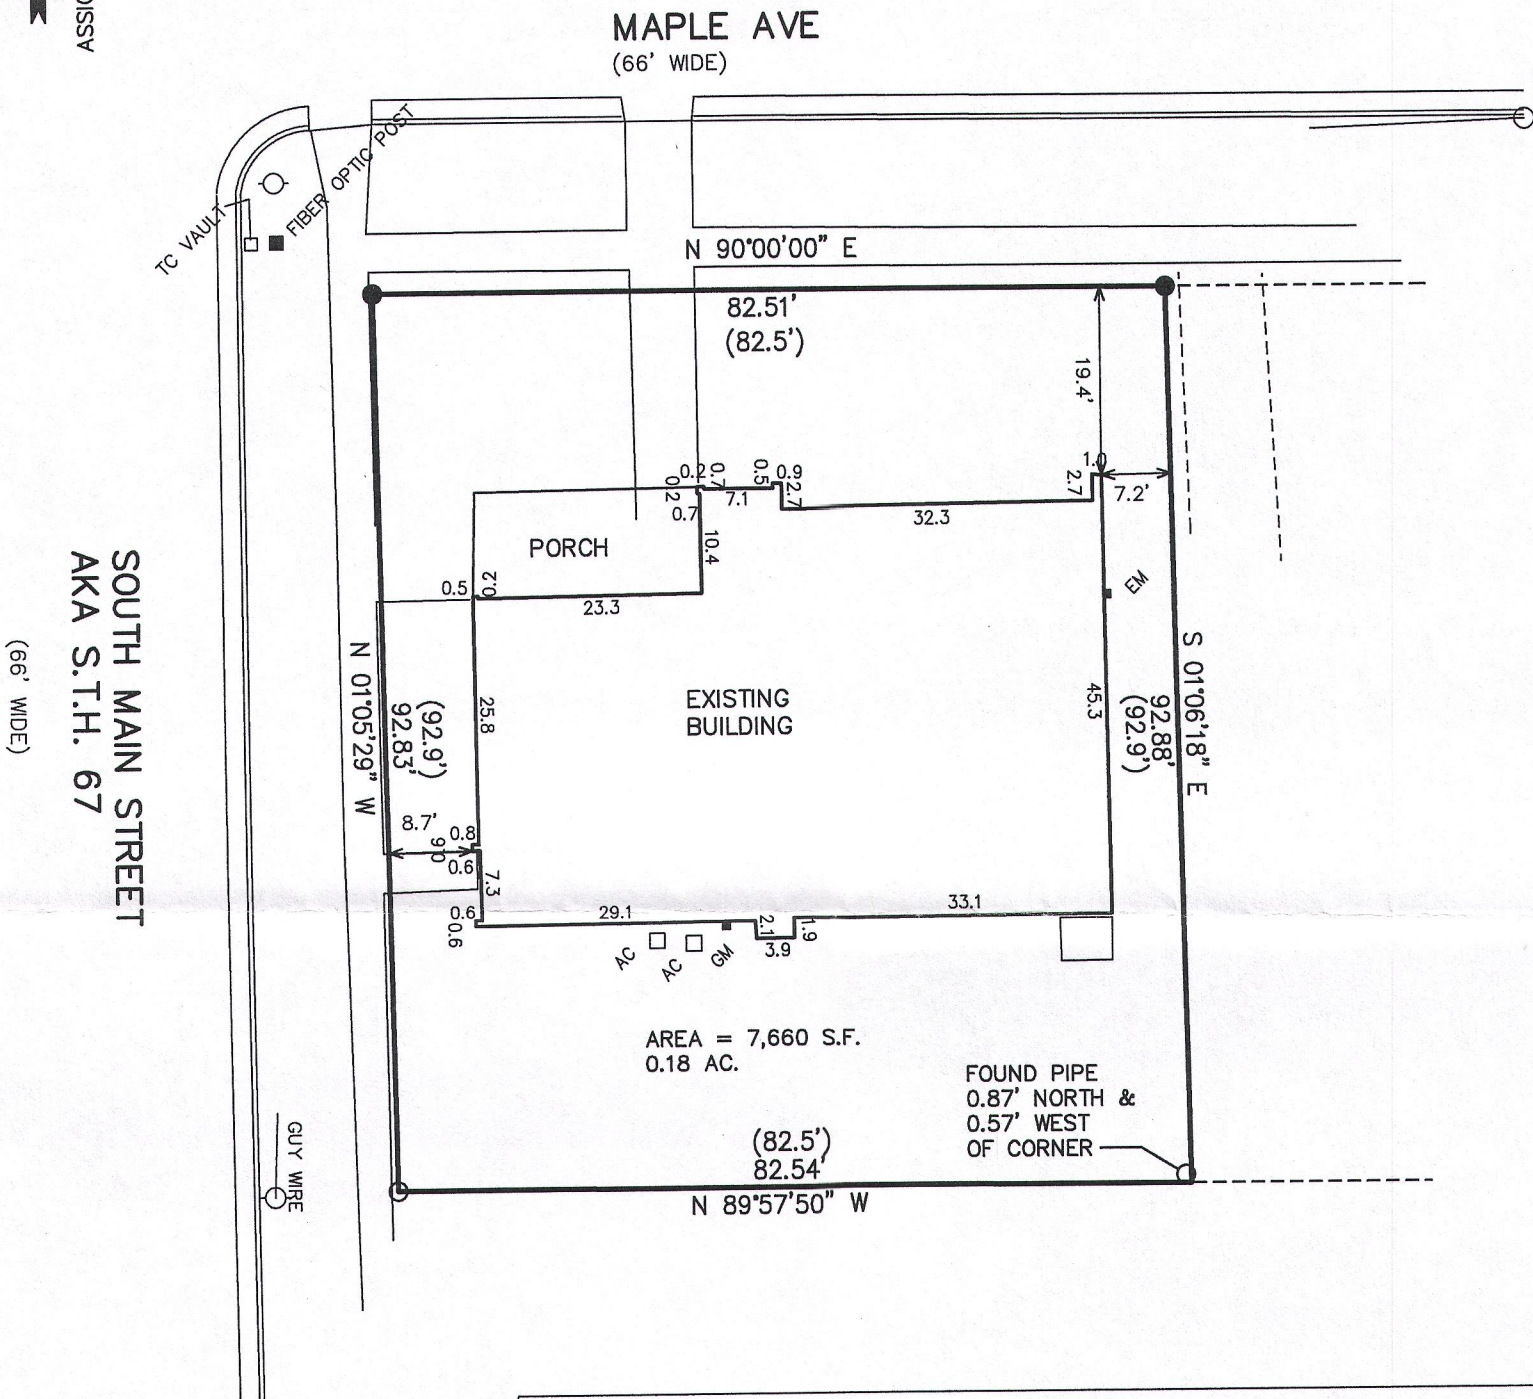

LEGEND


- = FOUND IRON PIPE STAKE
- = FOUND IRON REBAR STAKE
- (XXX) = RECORDED AS

The West 1/2 of Lot 34, in Clark's Addition to the Village of Walworth, excepting and reserving therefrom a strip of land 20 feet in width off from the South side of said Lot 34, said strip being of equal width across the South side of said West 1/2 of said Lot 34, according to the recorded plat thereof. Said land being in the Village of Walworth, County of Walworth, and State of Wisconsin

FOR INFORMATIONAL PURPOSES ONLY:

Property Address: 101 Maple St, Walworth, WI 53184

Tax Key Number: VCA 00045

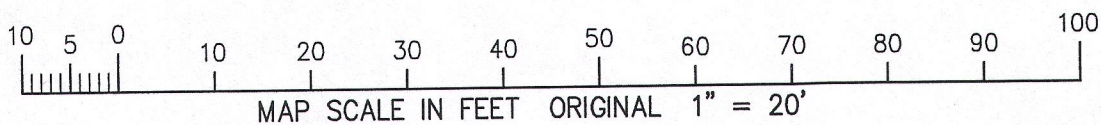


NOTE: COPIES OF THIS MAP TO WHICH THE FOLLOWING CERTIFICATE WILL APPLY SHOW THE SURVEYOR'S ORIGINAL SEAL AND SIGNATURE IN RED INK. COPIES BY ANY OTHER MEANS MAY HAVE ALTERATIONS WHICH DO NOT REPRESENT THE SURVEYOR'S WORK PRODUCT.

I HEREBY CERTIFY THAT THE ABOVE DESCRIBED PROPERTY HAS BEEN SURVEYED UNDER MY DIRECTION AND THAT THE ABOVE MAP IS A TRUE REPRESENTATION THEREOF AND SHOWS THE SIZE AND LOCATION OF THE PROPERTY, ITS EXTERIOR BOUNDARIES, THE LOCATION OF ALL VISIBLE STRUCTURES, AND DIMENSIONS OF ALL PRINCIPLE BUILDINGS THEREON, BOUNDARY FENCES, APPARENT EASEMENTS, ROADWAYS, AND VISIBLE ENCROACHMENTS, IF ANY. THIS SURVEY IS MADE FOR THE USE OF THE PRESENT OWNERS OF THE PROPERTY, AND ALSO THOSE WHO PURCHASE, MORTGAGE, OR GUARANTEE THE TITLE THERETO WITHIN ONE YEAR FROM THE DATE HEREOF.

DATED: SEPTEMBER 8, 2015

PETER S. GORDON P.L.S. 2101

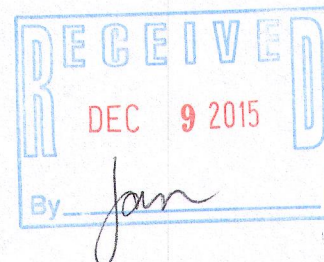

PROJECT: 9363.1
DATE: 09-082015
SHEET 1 OF 1