
## LAND-MARK SURVEYING

Mark L. Miritz

Wisconsin Professional Land Surveyor S-2582

N9330 Knuteson Drive Whitewater, WI 53190 Phone:(262)495-3284 MARKMIRITZ@ LAND-MARKSURVEYING.COM

ORDERED BY:
BECKY MERWIN
RAULAND AGENCY
118 KENOSHA ST.
WALWORTH, WI 53184

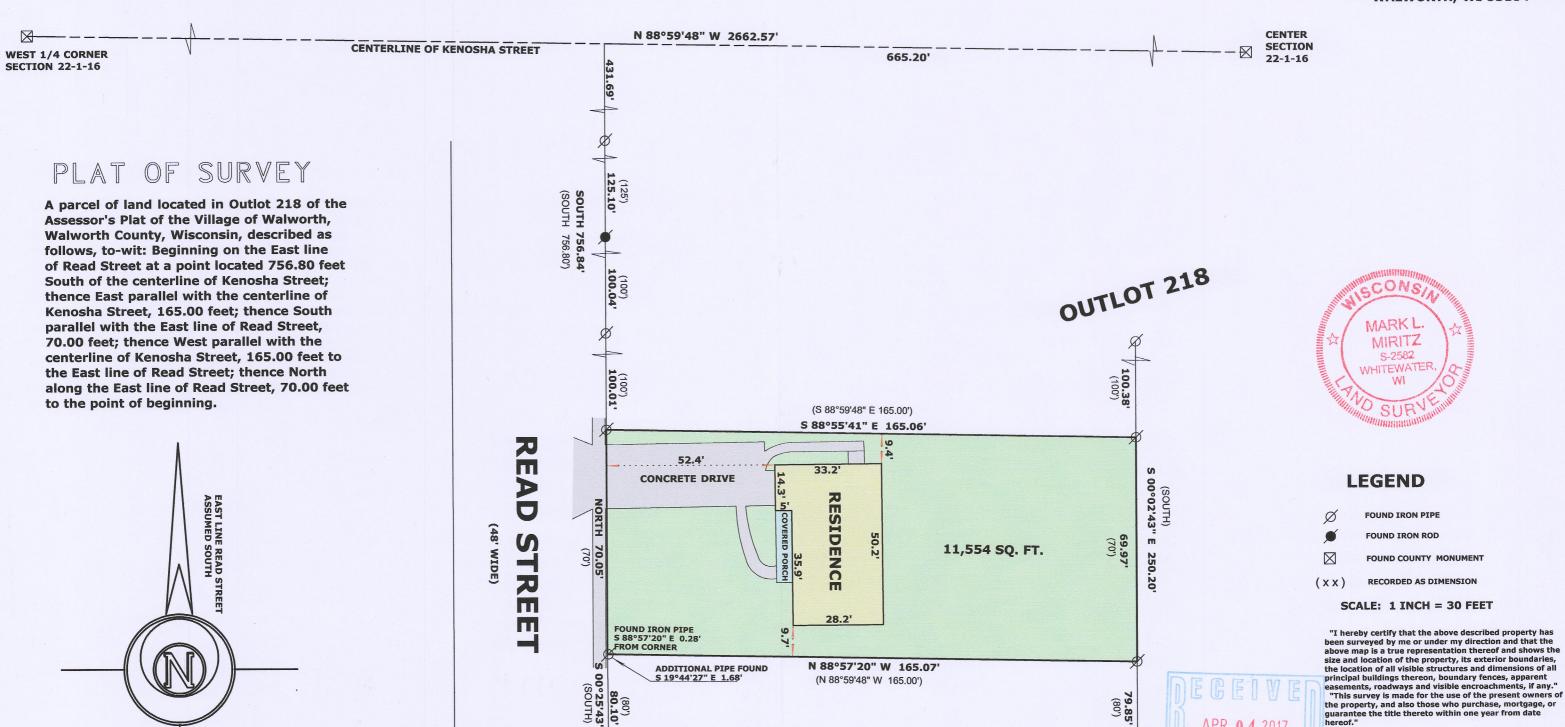

MARK L. MIRITZ

WISCONSIN PROFESSIONAL LAND SURVEYOR S-2582 DATE: MARCH 25, 2017 JOB NO. 17.206