LAND-MARK SURVEYING Mark L. Miritz


Wisconsin Professional Land Surveyor S-2582

N9330 Knuteson Drive Whitewater, WI 53190 Phone:(262)495-3284 MARKMIRITZ@ LAND-MARKSURVEYING.COM

PLAT OF SURVEY

LOTS 34, 35, AND 36, BLOCK 4, EAST SIDE 2ND ADDITION, LOCATED IN THE SOUTHWEST 1/4 OF SECTION 22, TOWN 1 NORTH, RANGE 16 EAST, VILLAGE OF WALWORTH, WALWORTH COUNTY, WISCONSIN.

ORDERED BY:
BOB RAULAND
THE RAULAND AGENCY
118 KENOSHA STREET
WALWORTH, WI 53184

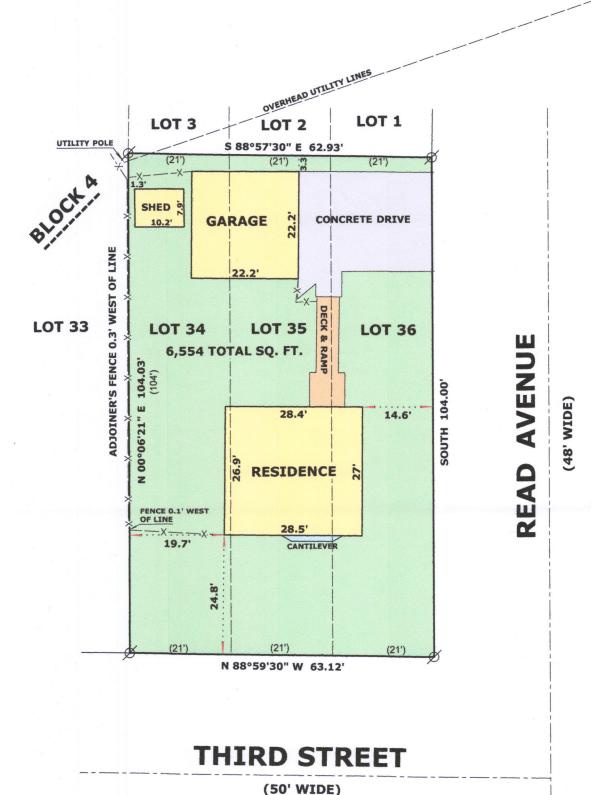


SURVEYOR'S NOTE:

DUE TO SNOW COVER THE SIDEWALKS WERE NOT LOCATED





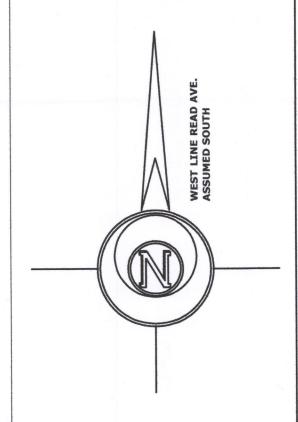

LEGEND

Ø FOUND IRON PIPE

(XX) RECORDED AS DIMENSION

—X—X — EXISTING WOOD FENCE

SCALE: 1 INCH = 20 FEET

"I hereby certify that the above described property has been surveyed by me or under my direction and that the above map is a true representation thereof and shows the size and location of the property, its exterior boundaries, the location of all visible structures and dimensions of all principal buildings thereon, boundary fences, apparent easements, roadways and visible encroachments, if any."

"This survey is made for the use of the present owners of

"This survey is made for the use of the present owners of the property, and also those who purchase, mortgage, or guarantee the title thereto within one year from date hereof."

MARK L. MIRITZ
WISCONSIN PROFESSIONAL
LAND SURVEYOR S-2582

DATE: FEB. 10, 2018 JOB NO. 18.202