


Plat of Survey

of


Lot 20 in Block 2 of Bigfoot Ridge  
of Walworth Addition No. 2,

located in the Southeast 1/4 of the Southwest 1/4 and the Southwest 1/4  
of the Southeast 1/4 of Section 22, Town 1 North, Range 16 East, Village  
of Walworth, Walworth County, Wisconsin.

Surveyed for: **Darrell & Nicole Kolp**  
N8247 Oak Hills Drive  
East Troy, Wisconsin. 53120

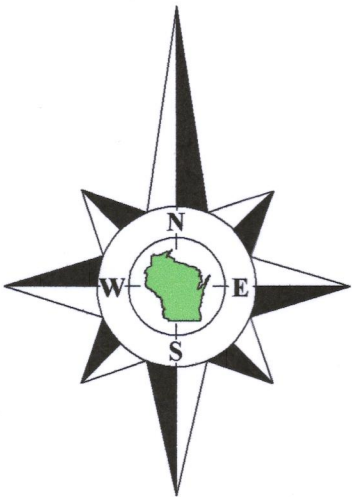


Bearings referenced to the West line of Lot 20 in Block 2  
recorded as N3°23'46"W on the plat of Bigfoot Ridge of  
Walworth Addition No. 2.

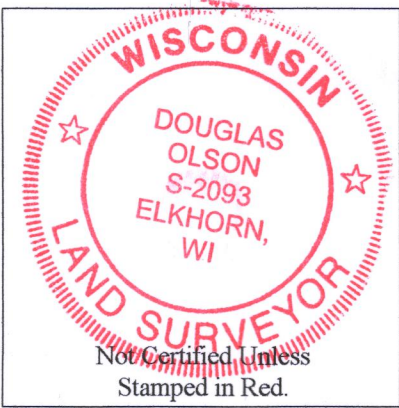

Notes:

- 1) This Plat of Survey is not certified unless signed and sealed in red ink.
- 2) This survey is subject to Wisconsin lien laws. This Plat of Survey is the notice of intent to file lien. Lien waiver required.
- 3) The Survey Date shown on this Plat of Survey is the completion date of the field work.

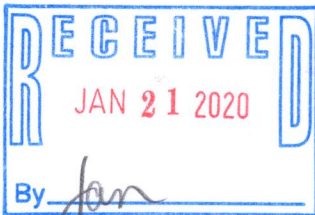


Copyright ©2019 by Olson Land Surveying, LLC.

All rights reserved. No part of this survey plat may be reproduced or transmitted in any form by any means - graphic, electronic, or mechanical, including photocopying, tracing, or information storage and retrieval systems - without permission in writing from Douglas G. Olson, Olson Land Surveying, LLC.


I hereby certify that I have surveyed the above described property in compliance with Chapter A-E 7 of the Wisconsin Administrative Code and that the map hereon is correct to the best of my professional knowledge and belief and shows the size and location of the property, its exterior boundaries, the location and dimensions of all visible structures thereon, boundary fences, apparent easements and roadways and visible encroachments, if any.

This survey is made for the exclusive use of the present owners of the property, and also those who purchase, mortgage or guarantee title thereto, within one year from the date hereof.

Douglas G. Olson  
Wisconsin Professional Land Surveyor - 2093

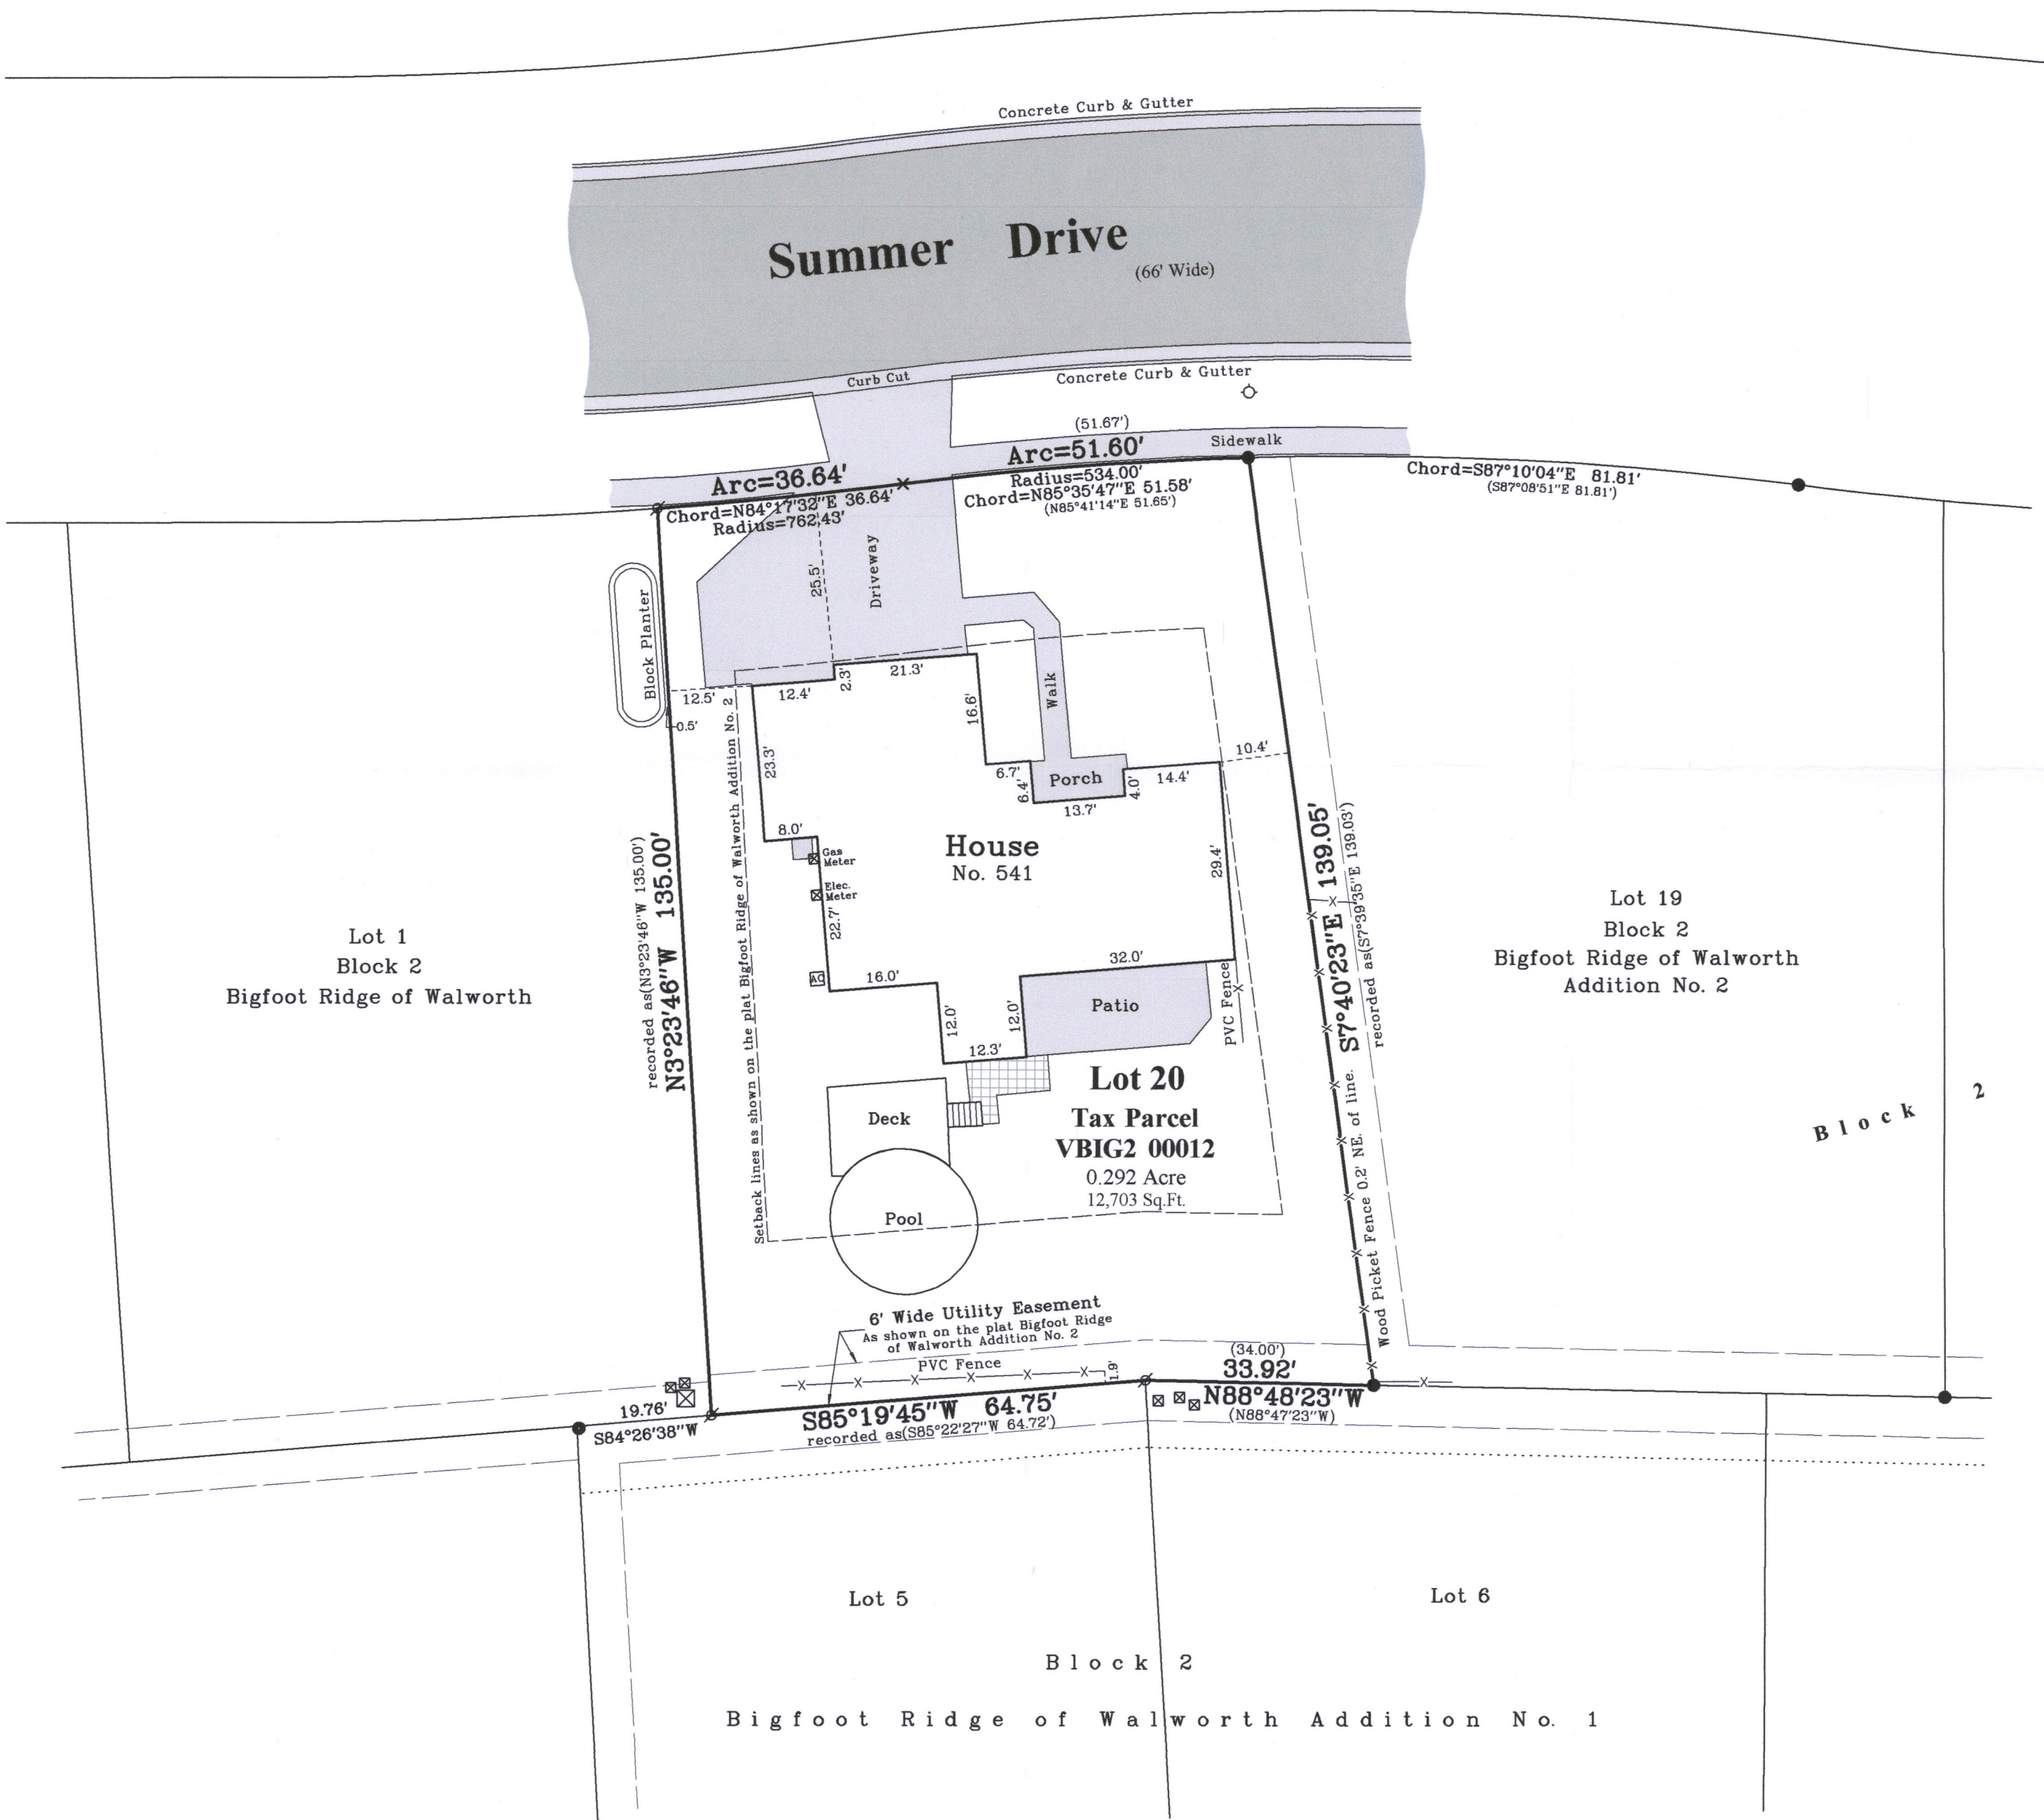

Survey Date: August 7, 2019.  
Revisions:

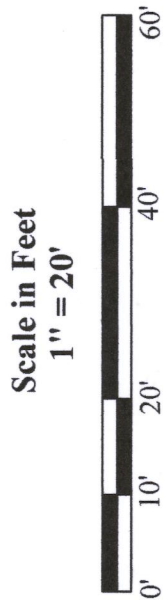

45 South Wisconsin Street | P.O. Box 322  
Elkhorn, Wisconsin, 53121  
Telephone: (262) 723-3434  
Fax: (262) 723-8044  
Email: doug@olsonsurveying.com  
Website: www.olsonsurveying.com

**OLSON**  
LAND SURVEYING, LLC  
Rural | Residential | Commercial

Legend of Symbols & Abbreviations  
N North  
S South  
E East  
W West  
in in  
ft ft  
B Bearings  
in in  
M Minutes  
S Seconds  
D Distances  
in in  
ft ft  
inches

Found Iron Pipe  
Found Iron Rod  
Set Cut Cross  
Recorded Information  
Utility Box or Pedestal  
Asphalt Surface  
Concrete Surface  
Patio Blocks

Sheet 1 of 1 Sheets  
Drawing Name  
Job Reference Number  
2019.103

2019.103

VBIG2-12 009-1319