

---	Existing Right-of-Way
=====	Existing Boundary Line
---	Existing Adjacent Property
●	3/4" Iron Rebar Found UNLESS NOTED
⊗	Existing Water Valve
⦿	Existing Fire Hydrant
⊙	Existing Sanitary Manhole
□	Existing Sign
⌂	Existing Mailbox
■	Existing Telephone Pedestal
⦶	Existing Electric Box
■	Existing Electric Pedestal
⦶	Existing Electric Meter
☀	Existing Ground Light
⦶	Existing Light Pole
⦶	Existing Air Conditioner



Kristin J. Belongia


State of Wisconsin } ss  
County of Rock }

*I hereby certify that I have supervised the survey of the property described above and to the best my knowledge and belief, the plat drawn hereon complies with Chapter A-E 7 of the State of Wisconsin Administrative Code, Minimum Standards for Property Surveys and correctly represents the size and location of the property, exterior boundaries, the location of all visible structures, and dimensions of all principle buildings thereon, fences, easements of record, and roadways, if any. This survey is made for the use of the present owners of the property, and also those who purchase, mortgage, or guarantee the title thereto within one year from the date hereof.*

Given under my hand and seal this 18th day of JANUARY, 2021 at Beloit, Wisconsin  
Last day of field work January 14th, 2021

*If the surveyor's signature is not red in color,  
the plan is a copy that should be assumed to  
contain unauthorized alterations.  
The certification contained on this document  
shall not apply to any copies.*

OF LOT 11 OF WHITETAIL RIDGE SUBDIVISION, BEING  
PART OF THE SW 1/4 AND SE 1/4 OF SECTION 15, T. 1 N.,  
R. 16 E., OF THE 4TH P.M., VILLAGE OF WALWORTH,  
WALWORTH COUNTY, WISCONSIN.

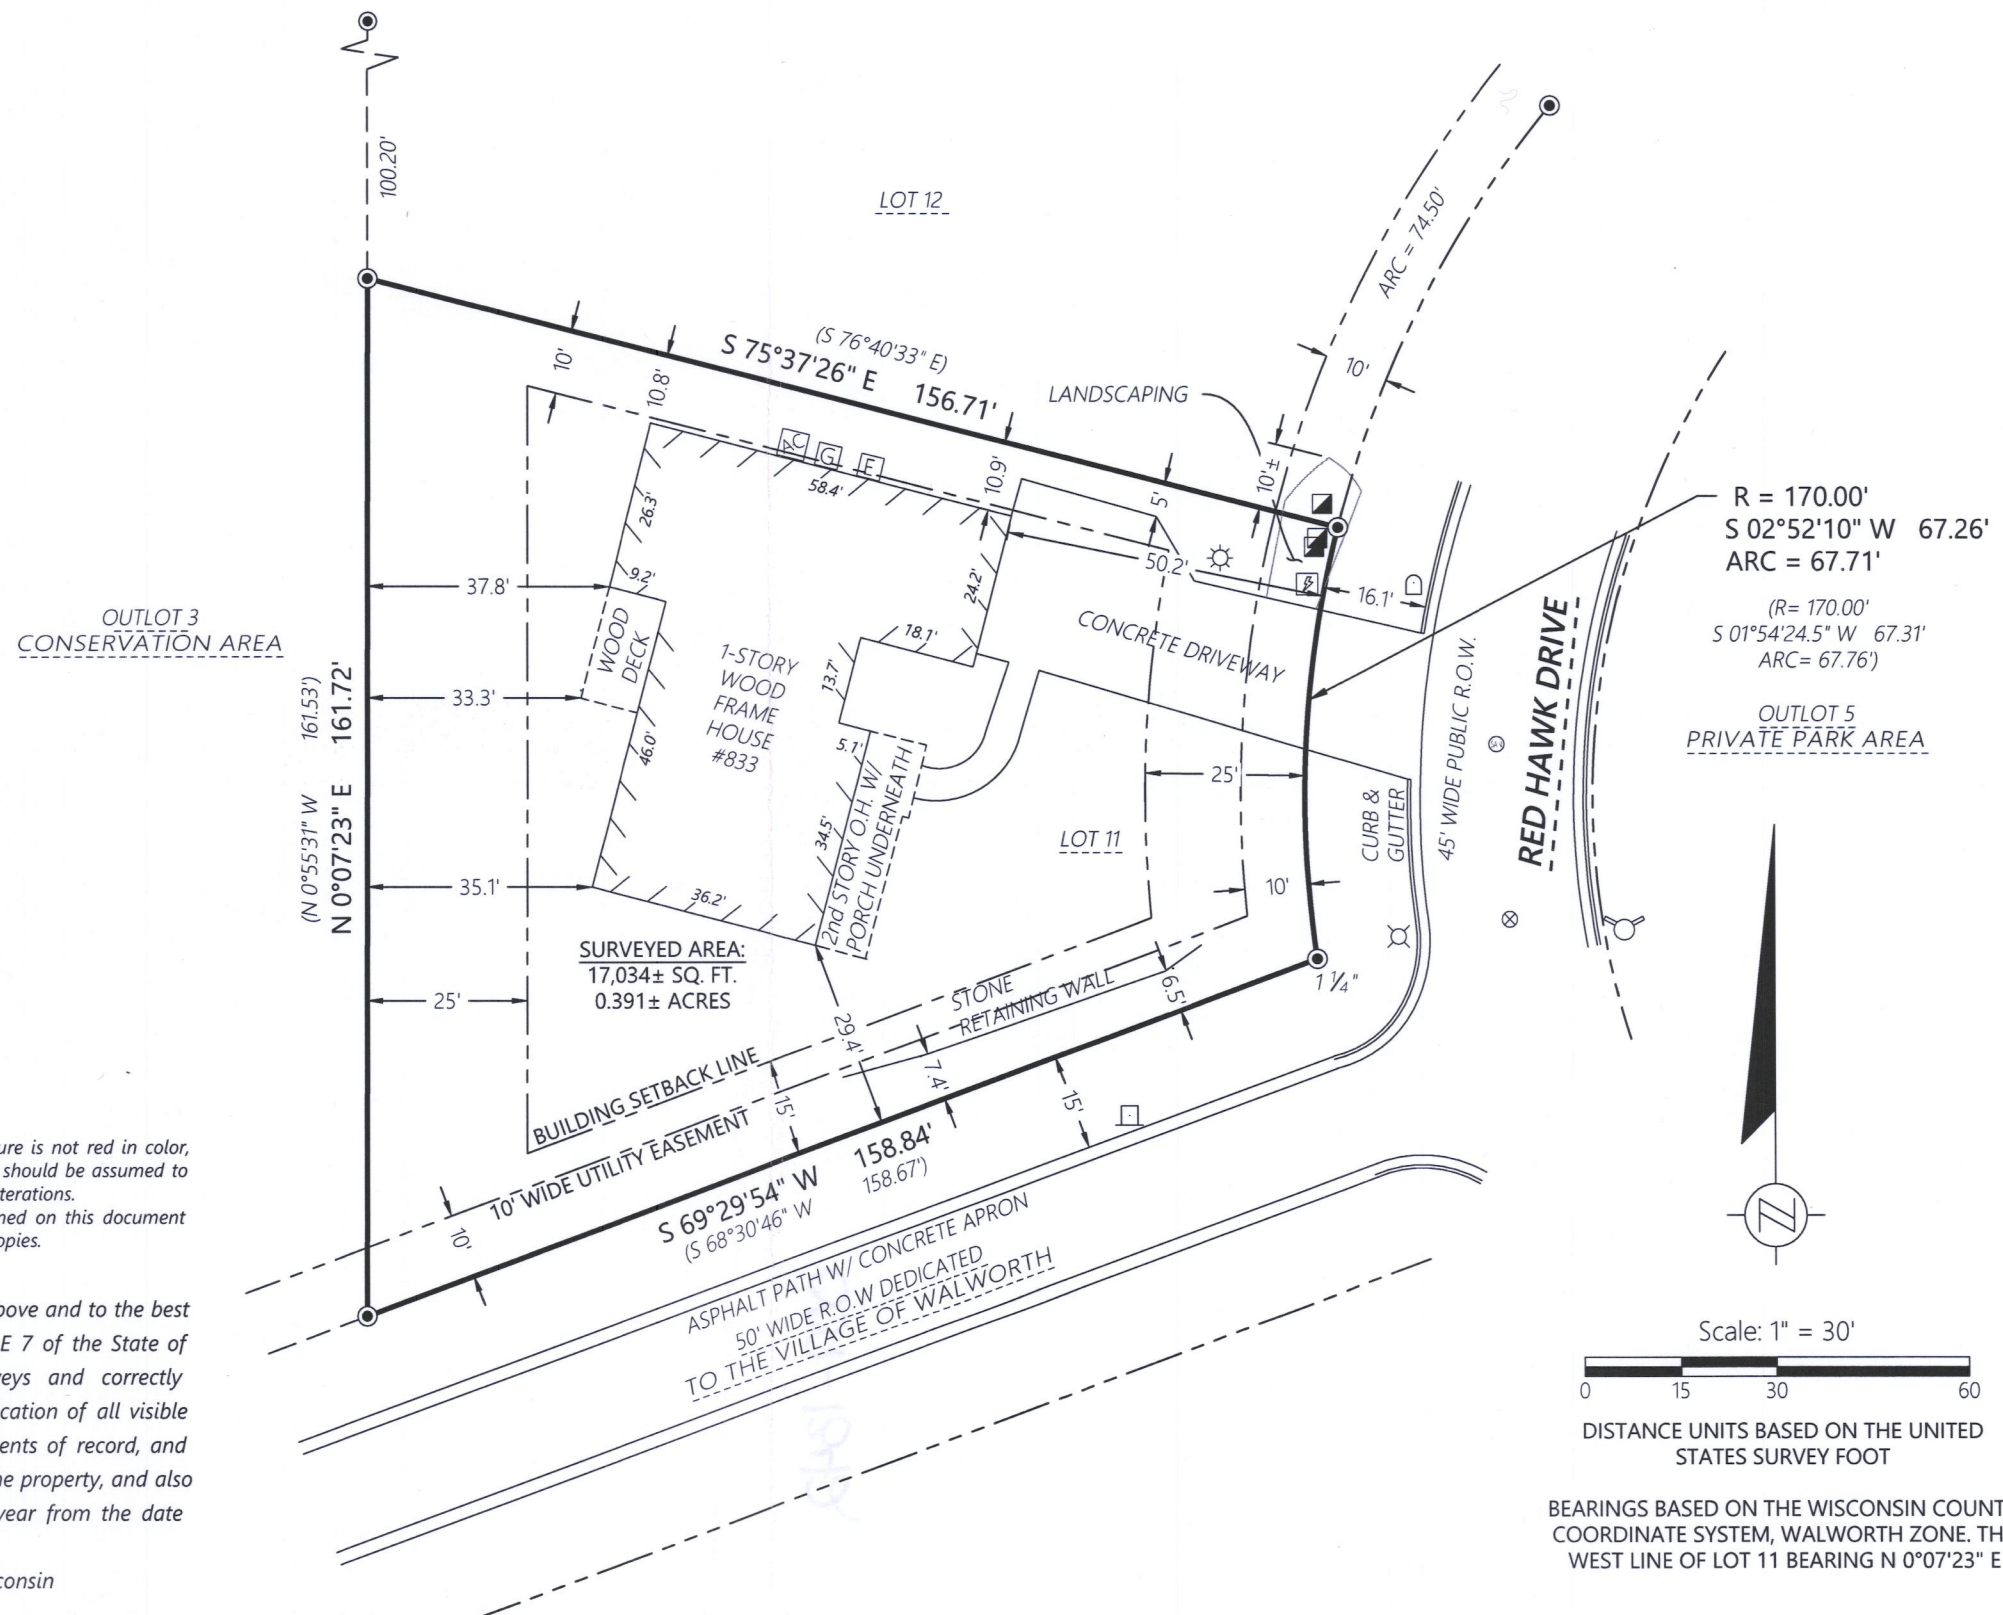

**Batterman**  
engineers surveyors planners  
2857 Bartells Drive  
Beloit, Wisconsin 53511  
608.365.4464  
[www.rhbatterman.com](http://www.rhbatterman.com)

# PLAT OF SURVEY

FOR THE EXCLUSIVE USE OF:  
The Rauland Agency  
118 Kenosha St  
Walworth, WI 53184

ORDER NO: 33822

FIELD CREW: BMR  
DRAWN BY: BMR

File Name: J:\33800-33899\33822 - Rauland Agency\SURVEY\RHB DRAWING FILES

VWR-11

009-1342