


GEORGE T. DUNHAM
SURVEYING & SUBDIVIDING
DELAVER, WISCONSIN

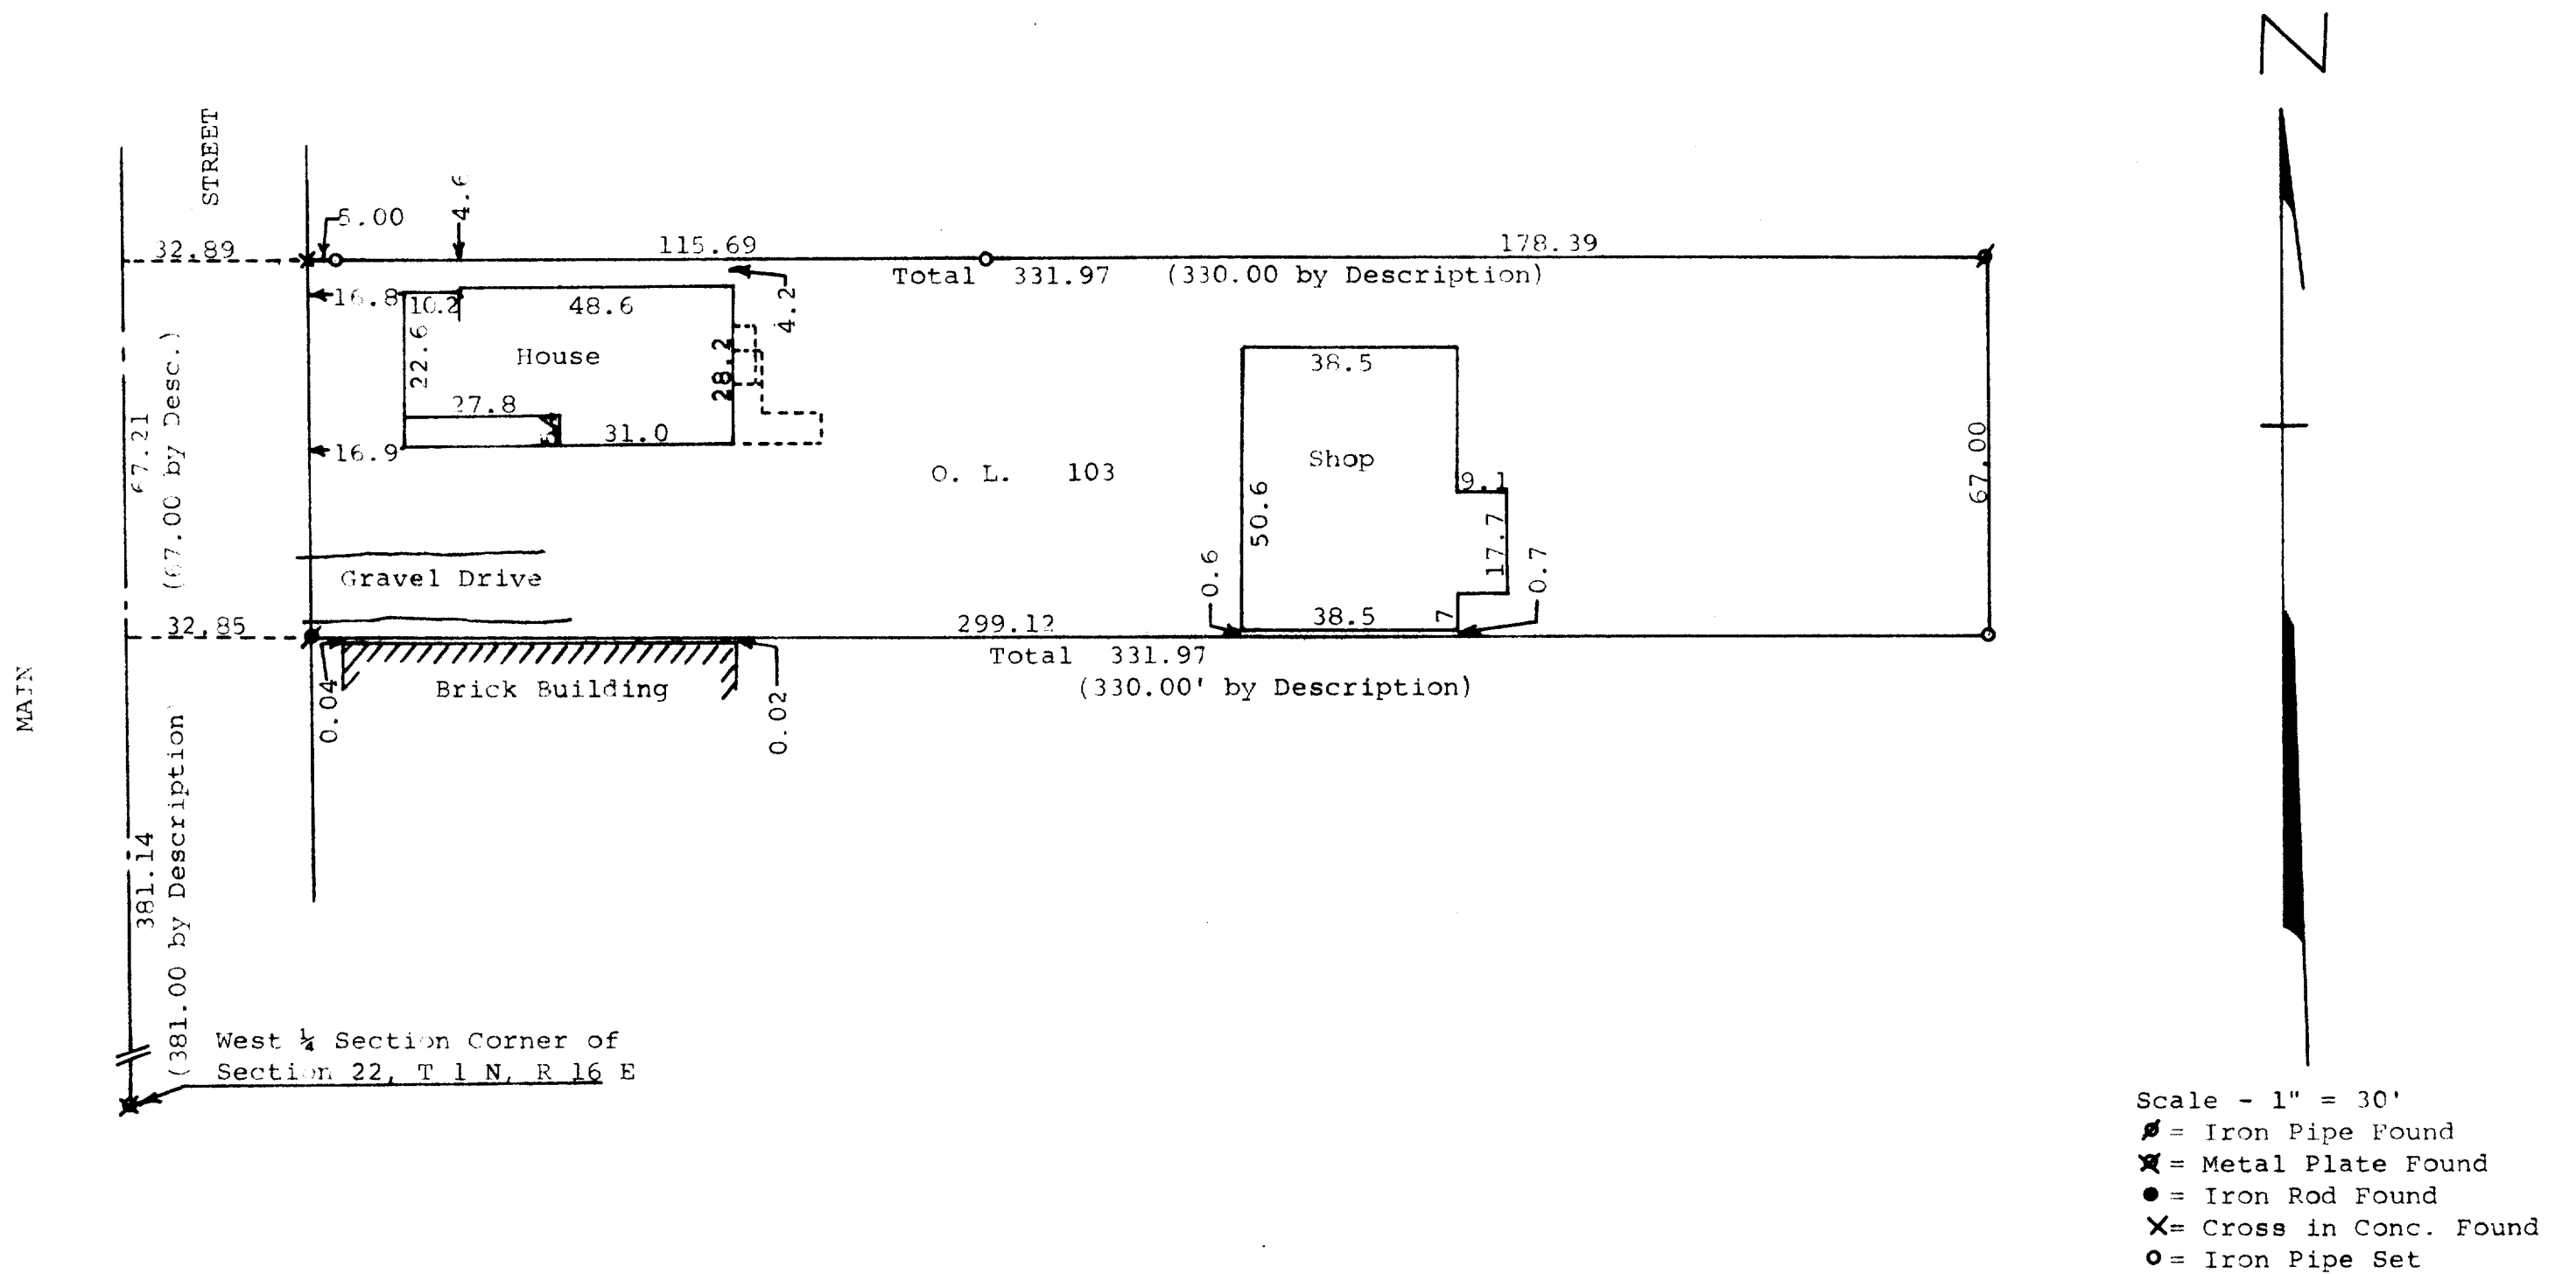

STATE OF WISCONSIN)
COUNTY OF WALWORTH) SS
I, George T. Dunham, Surveyor, certify that I have surveyed the property described as follows,
Outlot No. One Hundred Three (103) of the Assessor's Plat of the Village of Walworth, Walworth County, Wisconsin according to the plat thereof on record in Volume 11 of Plats on Page 15, in the Office of the Register of Deeds in and for said Walworth County, and the above map is a true representation thereof and shows the size and location of the property, its exterior boundaries, the location and dimensions of all structures thereon, fences, apparent easements and roadways and visible encroachments, if any.
This survey is made for the exclusive use of the present owners of the property, and also those who purchase, mortgage, or guarantee the title thereto within one (1) year from date hereof; and as to them I warrant the accuracy of said survey and map.
April 5, 1976

George T. Dunham
George T. Dunham, Surveyor

