


PLAT OF SURVEY

LEGAL DESCRIPTION


LOCATED IN THE SOUTHEAST 1/4 OF THE NORTHEAST 1/4, SECTION 6,  
 TOWNSHIP 1 NORTH, RANGE 17 EAST, IN THE VILLAGE OF WILLIAMS  
 BAY, WALWORTH COUNTY, WISCONSIN.

LOT 2 OF CERTIFIED SURVEY MAP NO. 3355, RECORDED IN VOLUME 19  
 OF CERTIFIED SURVEYS, PAGE 109, WALWORTH COUNTY.

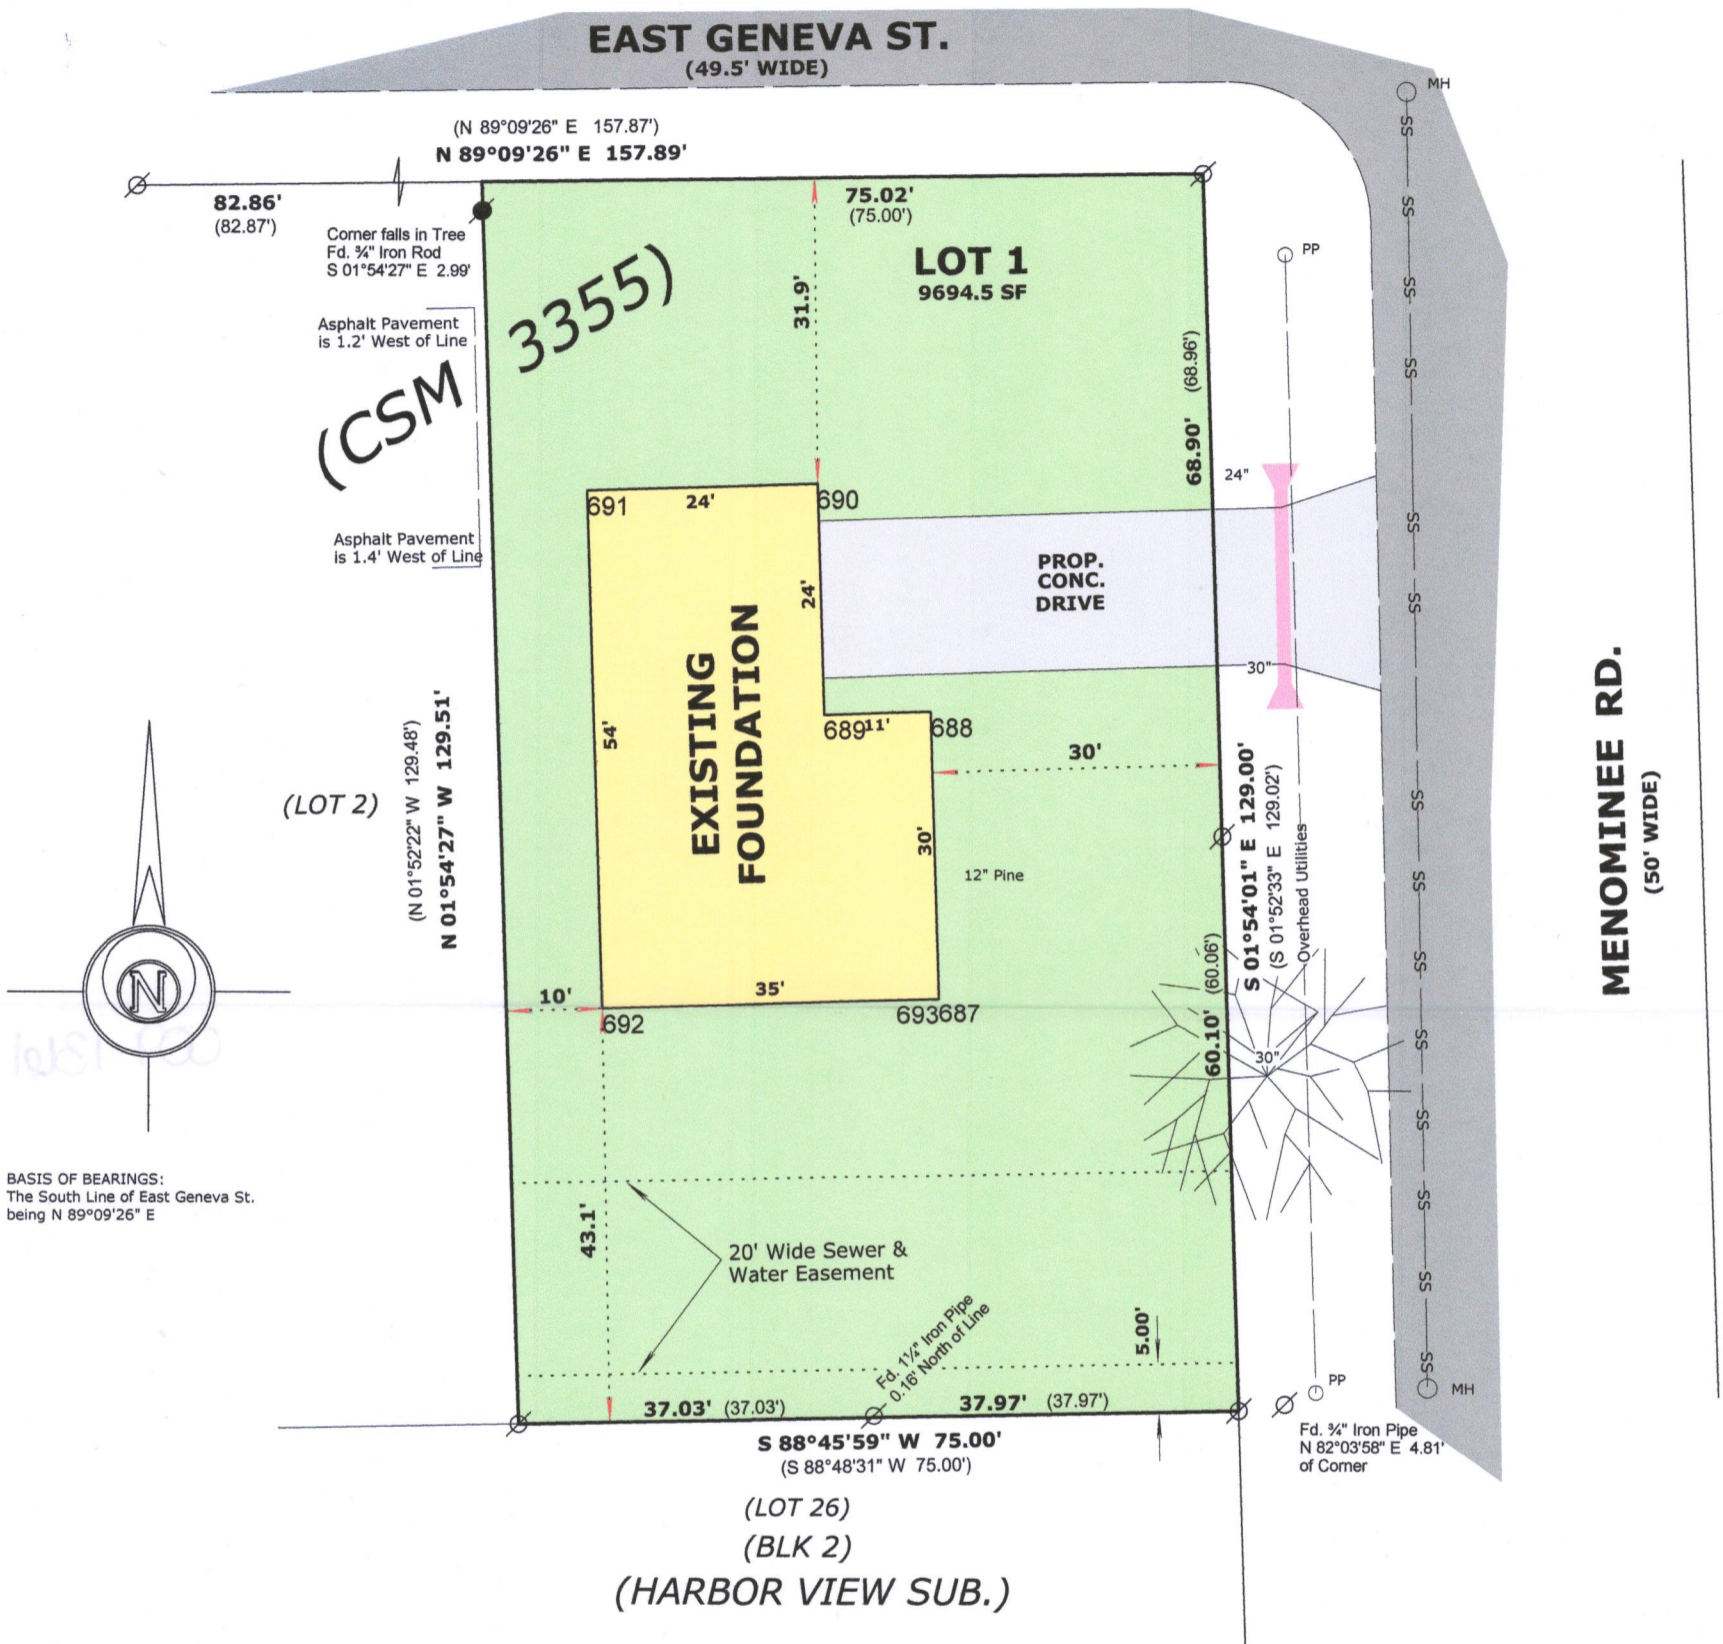

BASIS OF BEARINGS:  
 The South Line of East Geneva St.  
 being N 89°09'26" E

**ORDERED BY:**  
**Basso Builders Inc.**  
 405 Skyline Dr.  
 Lake Geneva, WI 53147

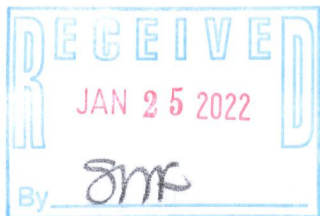

**LEGEND**

- FOUND IRON PIPE
- FOUND IRON ROD
- RECORDED AS DIMENSION

SCALE: 1 INCH = 20 FEET

"I hereby certify that the above described property has been surveyed by me or under my direction and that the above map is a true representation thereof and shows the size and location of the property, its exterior boundaries, the location of all visible structures and dimensions of all principal buildings thereon, boundary fences, apparent easements, roadways and visible encroachments, if any."  
 "This survey is made for the use of the present owners of the property, and also those who purchase, mortgage, or guarantee the title thereto within one year from date hereof."

*Mark L. Miritz*  
 MARK L. MIRITZ  
 WISCONSIN PROFESSIONAL  
 LAND SURVEYOR S-2582  
 DATE: July 21, 2021 JOB NO. 21.706

12/14/2021 to show foundation "AS BUILT"  
 9/11/2021 Add DW Culvert Revise Basin Location & Depth  
 8/09/2021 Revised for Grading Plan Purposes

WA3355-2

009-1361