
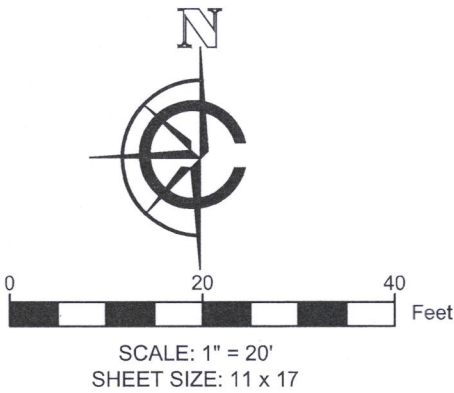


PLAT OF SURVEY

LEGAL DESCRIPTION:  
A PARCEL OF LAND LOCATED IN THE SOUTHWEST 1/4 OF THE SOUTHEAST 1/4 AND  
THE SOUTHEAST 1/4 OF THE SOUTHWEST 1/4 OF SECTION 15 IN TOWNSHIP 1 NORTH,  
RANGE 16 EAST, IN THE VILLAGE OF WALWORTH, WALWORTH COUNTY, WISCONSIN.

MORE PARTICULARLY DESCRIBED AS:  
LOT 24 OF WHITETAIL RIDGE SUBDIVISION AS RECORDED IN DOCUMENT NO. 666959  
PER THE WALWORTH COUNTY REGISTER OF DEEDS.

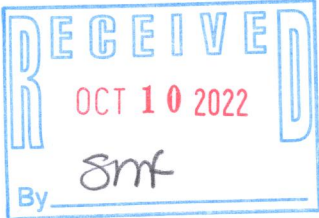

LEGEND	
	EXISTING BUILDING
	EXISTING ASPHALT
	EXISTING DECK
	FOUND 1" IRON PIPE
	FOUND IRON ROD
	FOUND CULVERT / INVERT
	MAJOR CONTOURS (Increments of 5)
	MINOR CONTOURS (Increments of 1)

BASIS OF BEARING:  
THE WISCONSIN STATE PLANE COORDINATE SYSTEM,  
NAD-83, SOUTH ZONE.  
SOUTHERN PROPERTY OF LOT 24, WHITETAIL RIDGE SUBDIVISION  
ASSUMED TO BE: N88°58'30"E

BASIS OF ELEVATION:  
ELEVATIONS ARE REFERENCED TO THE NORTH AMERICAN  
VERTICAL DATUM OF 1988 ("NAD88")

BUILDING SURVEYED TO:  
THE EXTERIOR OF SIDING.

SURVEY ORDERED BY:  
LOBERG VENTURES

PROPERTY ADDRESS:  
882 REDHAWK DRIVE  
WALWORTH, WI 53184


FIELD WORK COMPLETED ON:  
AUGUST 22, 2022

FIELD CREW CHIEF:  
MICHAEL MELENZIO

SURVEYOR:  
PAUL H. VAN HENKELUM, PLS  
CARDINAL ENGINEERING LLC

"I HEREBY CERTIFY THAT I HAVE SURVEYED THE ABOVE DESCRIBED PROPERTY  
AND THE MAP IS A TRUE AND CORRECT REPRESENTATION OF ITS EXTERIOR  
BOUNDARIES AND SHOWS THE SIZE AND LOCATION OF ALL VISIBLE STRUCTURES,  
APPARENT EASEMENTS AND ENCROACHMENTS, IF ANY."

PAUL H VAN HENKELUM, PLS #1931  
  
DATE

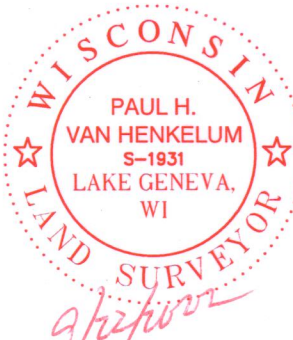

CARDINAL  
PLAN | SURVEY | ENGINEER

1200 LA SALLE ST.  
LAKE GENEVA, WI 53147  
262-757-8776  
PLANSURVEYENGINEER.COM

DATE: 09 / 21 / 2022  
SHEET 1 OF 1  
JOB No. 22394  
AJJ