
OFSURVEY


OUTLOT 135 OF THE ASSESSOR'S PLAT OF THE VILLAGE OF WALWORTH, ACCORDING TO THE RECORDED PLAT THEREOF. SAID LAND BEING IN THE VILLAGE OF WALWORTH, COUNTY OF WALWORTH AND STATE OF WISCONSIN.

SURVEY FOR: BECKY MERWIN OF BERKSHIRE HATHAWAY STARCK REAL SURVEY ADDRESS: 127 PARK STREET, WALWORTH, WI 53184 ESTATE

NOTE: REFER TO A CURRENT TITLE REPORT FOR EASEMENTS, RESTRICTIONS OR COVENANTS WHICH MAY AFFECT THIS PROPERTY.

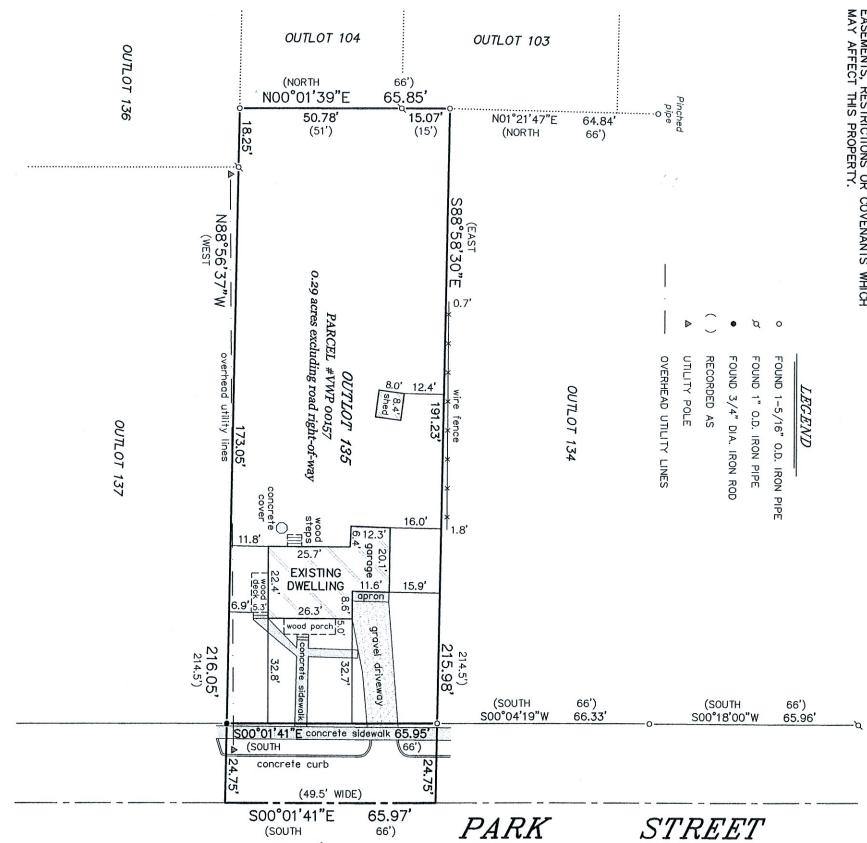

CONS

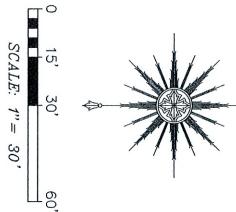

THE TITLE THERETO WITHIN ONE

IVEYED THE ABOVE
ABOVE MAP IS A
AND SHOWS THE SIZE
S EXTERIOR
VISIBLE STRUCTURES
BUILDINGS THEREON,
IENTS, ROADWAYS AND

SATTER SURVEYING, LLC LAND SURVEYS, MAPPING AND PLANNING 272 ORIGEN STREET BURLINGTON, WI 53105 262-661-4239

SURVE

THIS IS NOT AN ORIGINAL PRINT UNLESS THIS SEAL IS RED. Mad SATTER

OCTOBER 4, 2024
DATE

092406 JOB NUMBER