


**SURVEYING & SUBDIVIDING  
DELAN, WISCONSIN 53115**



George T. Dunham  
George T. Dunham, Surveyor

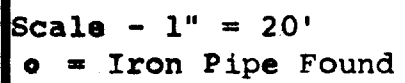