


DUNHAM SURVEYING, S.C.  
SURVEYING & SUBDIVIDING  
DELAVAN, WISCONSIN 53115


The Iron pipe was not located at this time because the owner of the property to the northwest of Lot 2, would not allow us to dig in the driveway. However an iron pipe was found at this corner in a survey made in 1952, which shows the distance along Madison Street to be 135.64 feet.

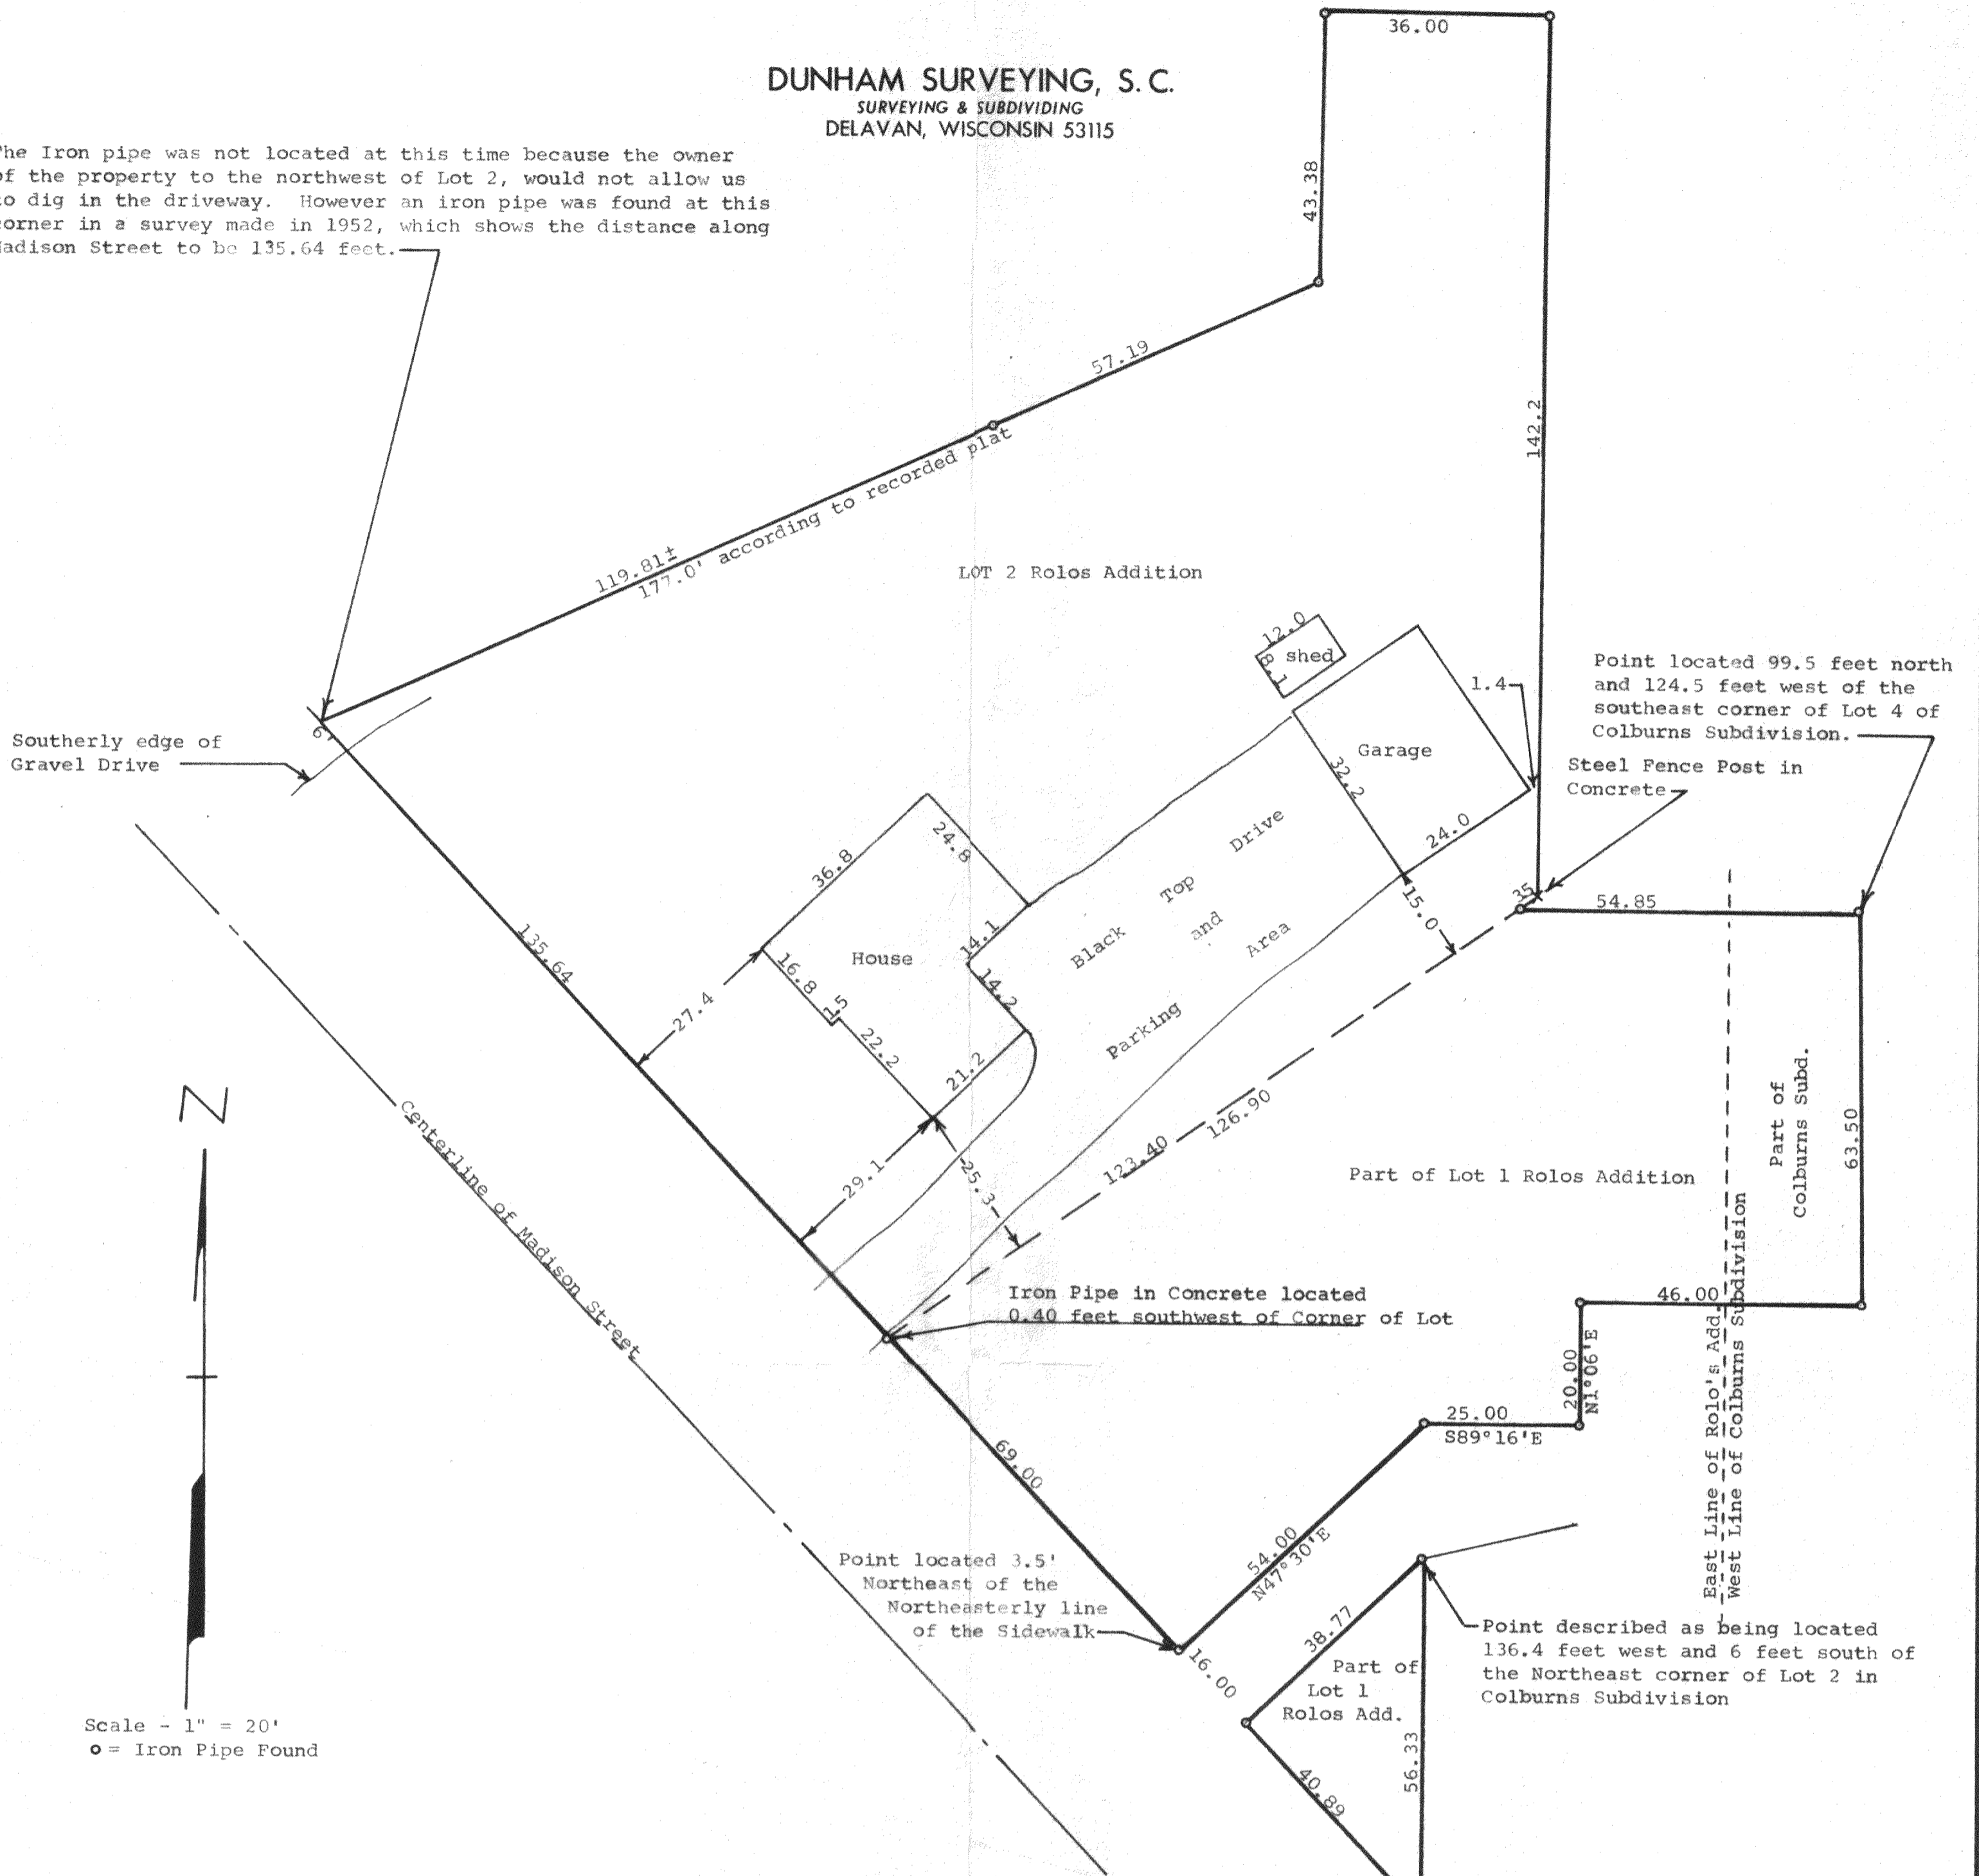

Scale - 1" = 20'  
○ = Iron Pipe Found

Plat of survey of:  
Lot 2 of Rolos Addition to the Village of Walworth, Walworth County, Wisconsin  
ALSO a part of Lot 1 of Rolos Addition and a part of Lot 3 of Colburns Subdivision  
located in the Village of Walworth, Walworth County, Wisconsin, described as  
follows: Commencing at the southeast corner of Lot 4 of said Colburns Subdivision  
thence North along the east line of said Lot 4, 99.5 feet; thence West parallel  
with the north line of said Lot 4, 124.50 feet to the place of beginning; thence  
continue West on the same line extended 54.85 feet to the westerly line of said  
Lot 1 of Rolos Addition; thence southwesterly along said westerly line of Lot 1  
of Rolos Addition 123.40 feet to the northeasterly line of Madison Street; thence  
southeasterly along the northeasterly line of said street 69.00 feet; thence  
N47°30'E at right angles to said street 54.00 feet; thence S89°16'E 25.00 feet;  
thence N1°06'E 20.00 feet; thence easterly 46.00 feet to an iron pipe located  
63.50 feet south of the place of beginning; thence northerly 63.50 feet to the  
place of beginning.  
ALSO a part of Lot 1 of the aforementioned Rolos Addition to the Village of Walworth  
described as follows: Beginning at a point located 136.4 feet west and 6 feet south  
of the northeast corner of Lot 2 of Colburns Subdivision; thence South 56.33 feet  
to the southwesterly line of said Lot 1; thence northwesterly along the southwesterly  
line of said Lot 1, 40.89 feet to a point located 16.00 feet southeast of the north-  
west end of a drive; thence northeasterly 38.77 feet to the place of beginning.  
December 16, 1977

*George T. Dunham*  
George T. Dunham, Surveyor

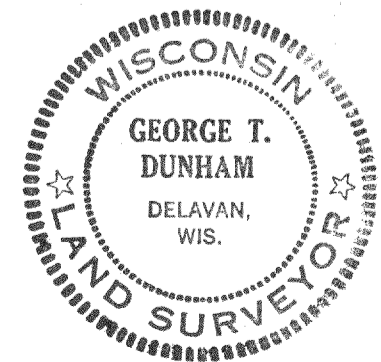

9-164

\* WRA-2  
u-8 + VCB-4, VRA-8