
DUNHAM SURVEYING, S. C. SURVEYING & SUBDIVIDING DELAYAN, WISCONSIN 53115



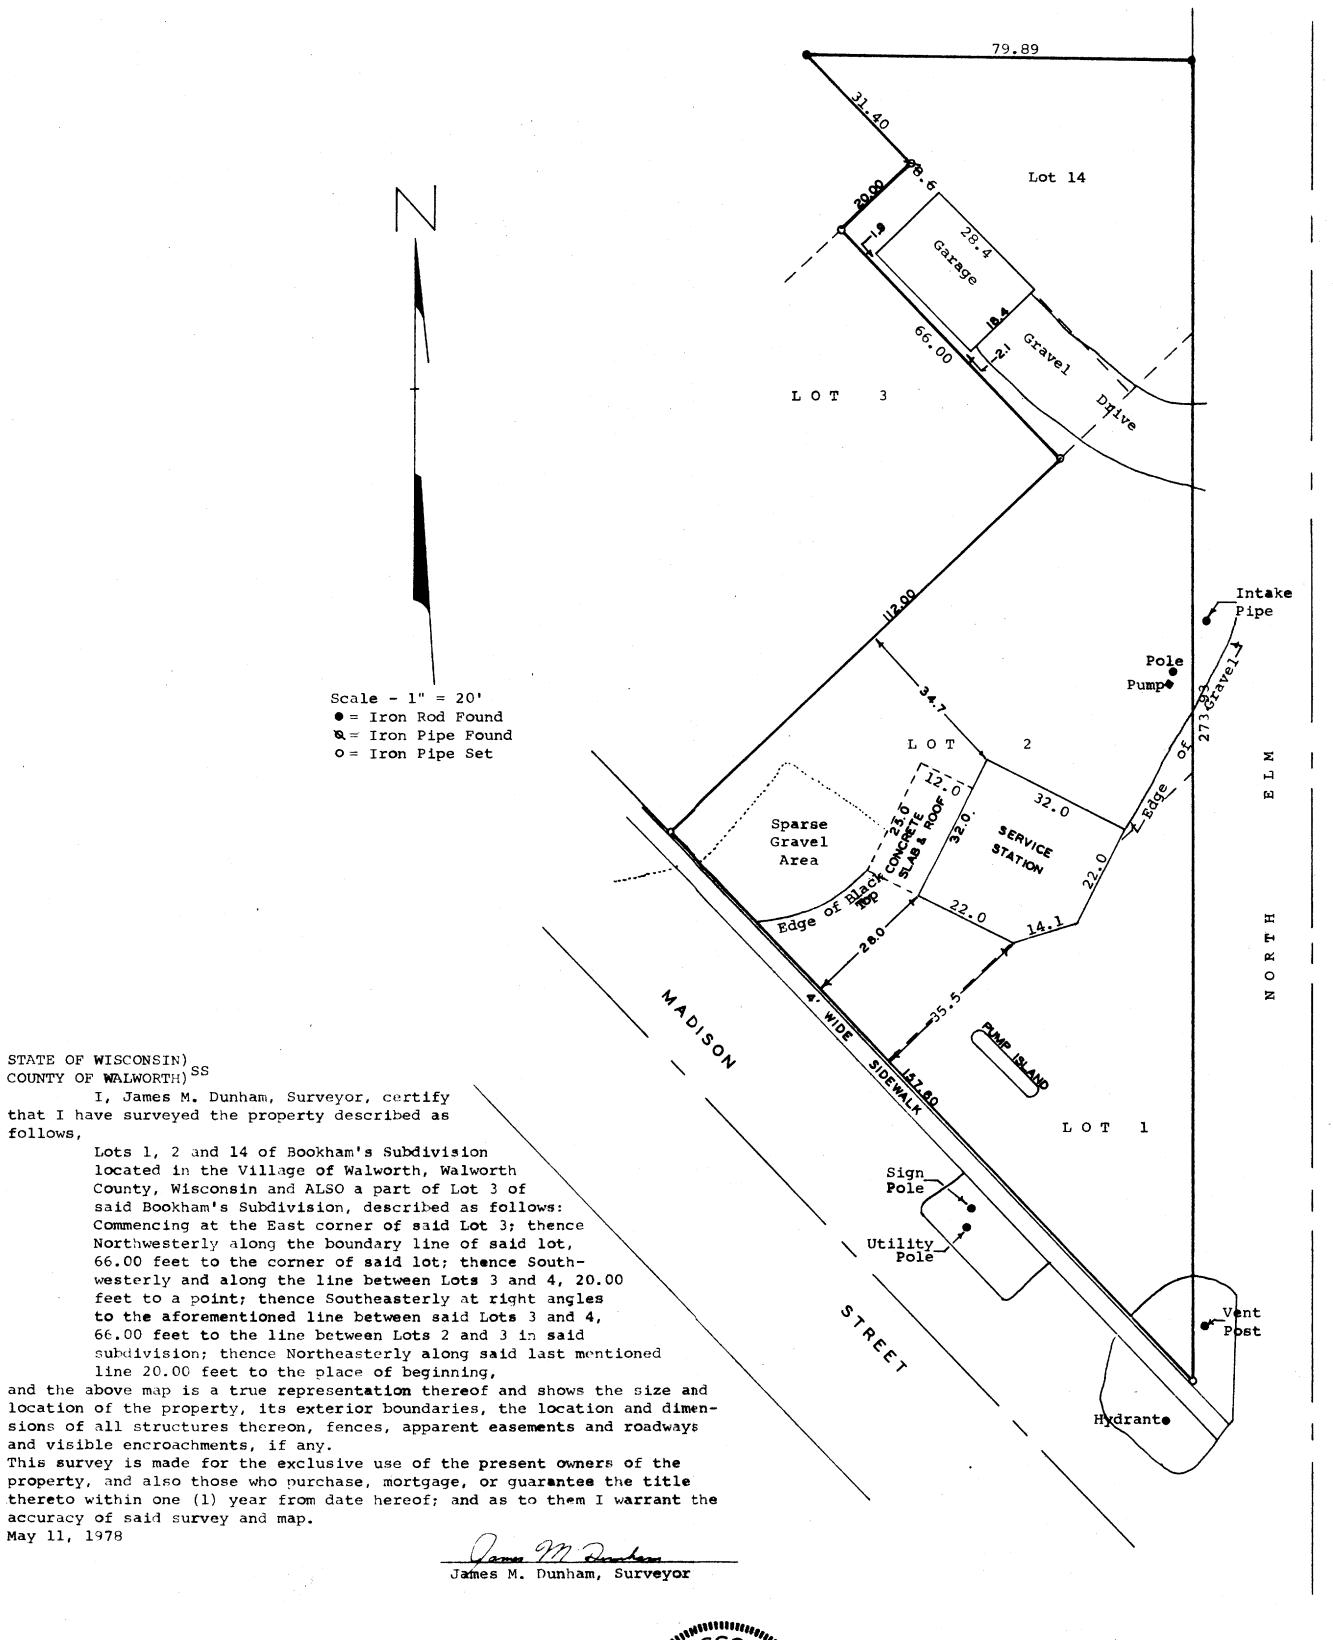

K & # 10-9155 250-9-76