FARRIS. HANSEN & COOPER. INC

FURNISHED NA SUBVEYING AND LAND PLANNING 715 W. WALWORTH ST. - P.O. BOX 487 - ELKHORN, WI 53121 OFFICE: 414/723-2098


DANIEL D. COOPER ROBERT A. FARRIS LAND SURVEYOR

SURVEYING & PLANNING SUBDIVISIONS - LOT SURVEYS CONSTRUCTION STAKING - MAPPING

WARREN E. HANSEN PROFESSIONAL ENGINEER

ENGINEERING MUNICIPAL - STRUCTURAL HIGHWAYS - PUBLIC WORKS

PLAT OF SUPPRY OF PART OF OUTLOT 118 OF THE ASSESSORS PLAT OF THE VILLAGE OF WALWORTH AS DESCRIBED IN VOLUME 62 ON PAGE 818 OF WALWORTH COUNTY RECORDS AS DOCUMENT NO. 645644

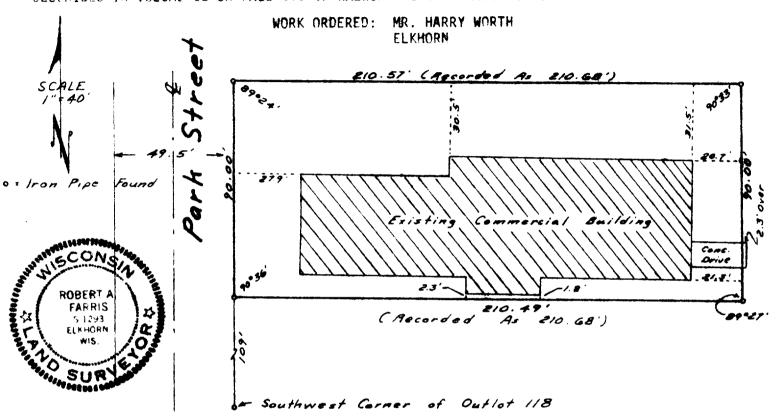

Beginning at a point on the East line of Park St. in the Village of Walworth 109 feet North of the Southwest corner of Outlot 118 of the Assessor's Plat of the Village of Walworth (said point being also the Northwest corner of property heretofore conveyed by the Village of Walworth to Earl Quaas); thence East paralled to the South line of said Outlot 118 a distance of 210.68 feet; thence North parallel to the West line of Park Street 90 feet; thence West parallel to the South line of Outlot 118 to the East line of Park Street: thence South along the East line of Park Street 90 feet more or less to the place of beginning.

I hereby certify that I have surveyed the above described property and that this map is a true representation thereof and shows the size and location of the property, its exterior boundary, the location and dimensions of all visible structures thereon, fences, apparent easements, roadways, and visible encroachments if any. This survey is made for the exclusive use of the present owners of the property and also those who purchase, mortgage or guarantee the title thereto within one year from the date hereof.

Dated this 27th day of July, 1978. Robert Q. Forris

Drawing No. 1365 -1800